

(AZ-BUILTS) 2016

DESIGNED: C. MANISZKE
CHECKED: L. BERON
DRAFTED: R. GRANTHAM
XREFS:
SCALE:
LAYOUT: A1
DATE TIME: 9/11/2015 11:42
DRAWING LOCATION: \DOT\BFR\802\Projects\Gp\6440\Plans\6440_A1_Tst.dwg

STATE OF ALASKA

DEPARTMENT OF TRANSPORTATION AND PUBLIC FACILITIES


PROPOSED HIGHWAY PROJECT

SGY: KLONDIKE HIGHWAY REPAIRS

PROJECT NO. Z684800000~0972017

PREVENTATIVE MAINTENANCE, OVERLAY AND GUARDRAIL REPLACEMENT

December 2, 2015

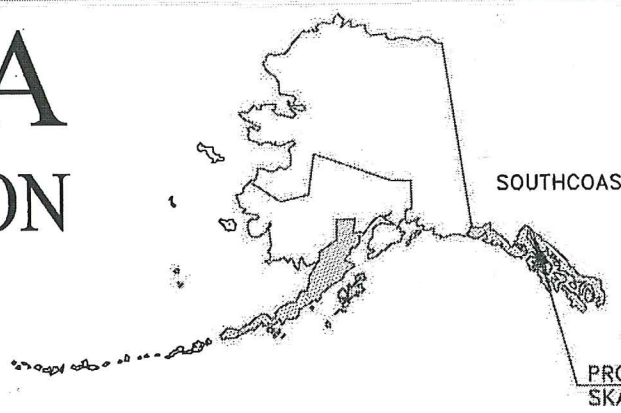

REVISIONS			STATE	PROJECT DESIGNATION	YEAR	SHEET NO.
NO.	DATE	DESCRIPTION	ALASKA	Z684800000~0972017	2015	A1
						PLAN SET TOTAL 25
			CDS ROUTE: 299500		MILEPOINT: 2.70 TO 3.24	
			LATITUDE: 59°30'08"N		LONGITUDE: 135°15'51"W	


INDEX OF SHEETS	
SHEET NO.	DESCRIPTION
A1	TITLE SHEET
A2	SHEET LAYOUT INDEX
A3	LEGEND & SHEET LAYOUT INDEX
A4-A5	SURVEY CONTROL PLAN
B1-B2	TYPICAL SECTIONS
C1	ESTIMATE OF QUANTITIES
D1	SUMMARIES
E1-E3	MISCELLANEOUS DETAILS
F1-F6	PLAN & PROFILE
P1-P6	EROSION SEDIMENT CONTROL PLANS & DETAILS
T1	TRAFFIC CONTROL PLANS

The undersigned hereby certifies that this duplicated document is an exact and true copy of the original.

Cody Sutter

PROJECT SUMMARY	
KLONDIKE HIGHWAY MP 2.70-3.20	
WIDTH OF PAVEMENT	28 FT
LENGTH OF PAVING	0.57 MILES
LENGTH OF PROJECT	0.57 MILES

DESIGN DESIGNATIONS	
PROJECT TYPE	PM
PRESENT A.D.T. (2012)	360
DESIGN YEAR A.D.T. (2021)	380
PEAK SEASONAL A.D.T. (2012)	748
PERCENT COMMERCIAL TRUCKS	24.8%
DIRECTIONAL DISTRIBUTION	55/45
DESIGN SPEED	40 M.P.H.
PAVEMENT DESIGN YEAR	2021
DESIGN VEHICLE	WB-50
FUNCTIONAL CLASSIFICATION	RURAL OTHER PRINCIPAL ARTERIAL

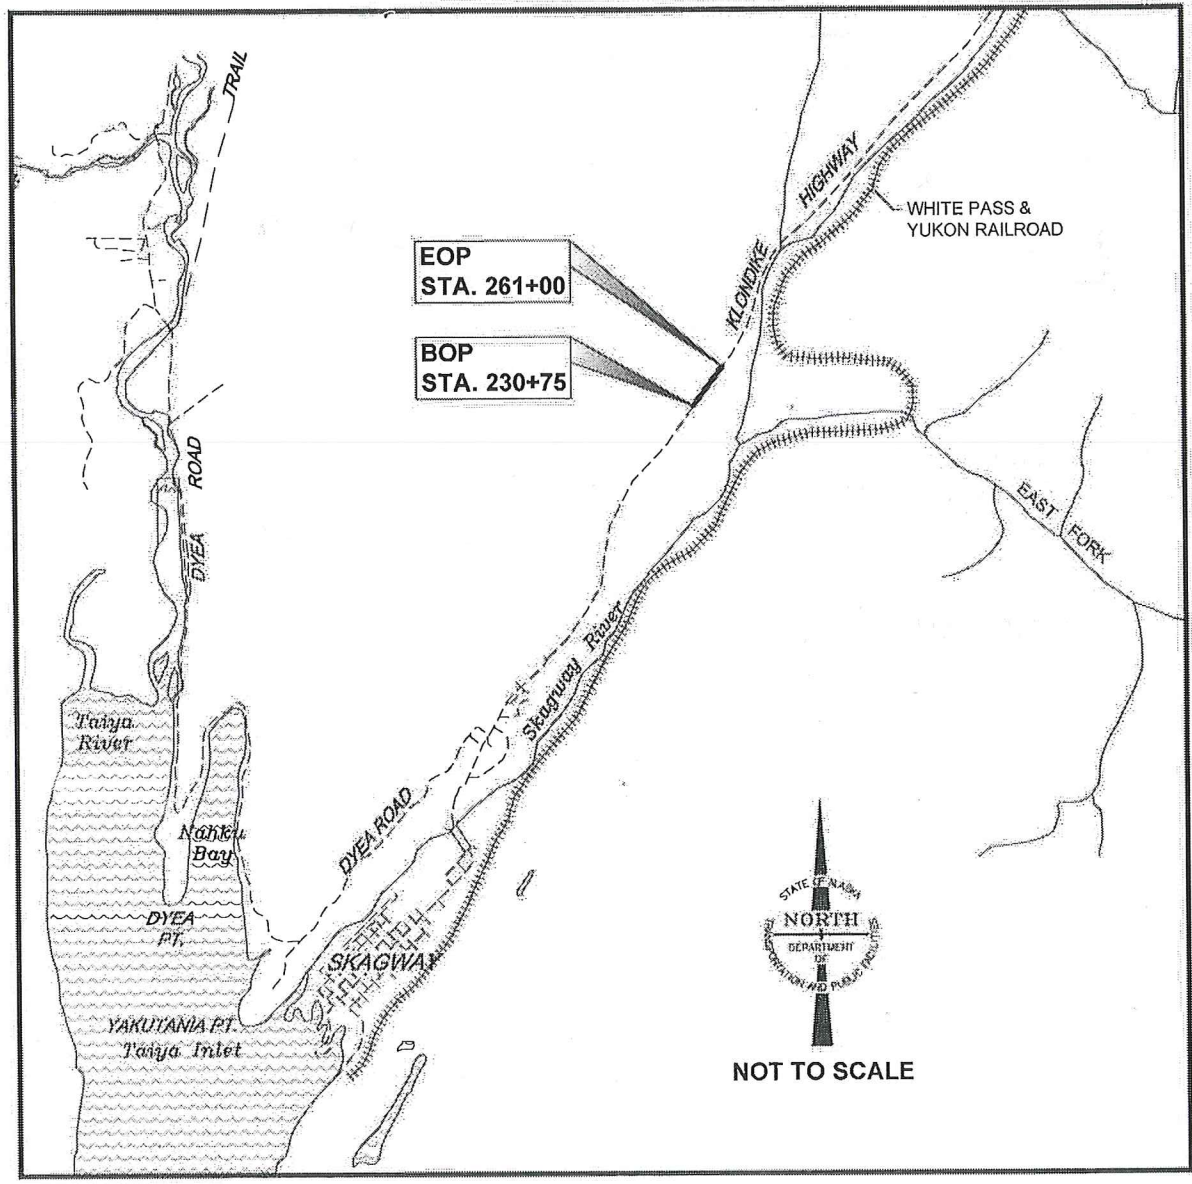

"As-Built" Plans

Contractor: Southeast RoadBuilders

Project Engineer: Todd Fleming

Begin Construction: 30 April 2016

End Construction: 30 June 2016

THE FOLLOWING STANDARD DRAWINGS APPLY TO THIS PROJECT:					
C-05.20	D-01.02	G-13.00	I-81.00	M-13.01	T-20.03
	D-04.21	G-20.11		M-16.01	T-21.03
	D-14.10	G-00.02			T-22.03
		G-04.10W			
		G-10.01			
		G-15.10			
		G-28.00			

USE THESE PLANS IN CONJUNCTION WITH THE STATE OF ALASKA STANDARD SPECIFICATIONS FOR HIGHWAY CONSTRUCTION, 2015 EDITION AND THE PROJECT SPECIAL PROVISIONS.

STATE OF ALASKA
DEPARTMENT OF TRANSPORTATION & PUBLIC FACILITIES

APPROVED: *[Signature]* 9/16/15
REGIONAL PRECONSTRUCTION ENGINEER DATE


CONCUR: *[Signature]* 9/16/15
DIRECTOR, DESIGN & CONSTRUCTION DATE

CERTIFIED TRUE & CORRECT AS-BUILT OF ACTUAL FIELD CONDITION:

CONSTRUCTION PROJECT MANAGER: _____ DATE: _____

DESIGNED: C. IVANISZEK
CHECKED: J. BROWN
DRAFTED: R. GRANTHAM
XREFS
SCALE
LAYOUT: A2
DATE: 10/6/2015 9:13
TIME
DRAWING LOCATION
C:\Sp\68480\Plans\68480_A2_Layout.dwg

NO.	DATE	REVISION	STATE	PROJECT DESIGNATION	YEAR	SHEET NO.	TOTAL SHEETS
2	10/6/15	ADDENDUM NO.2	ALASKA	Z684800000~0972017	2015	A2	5

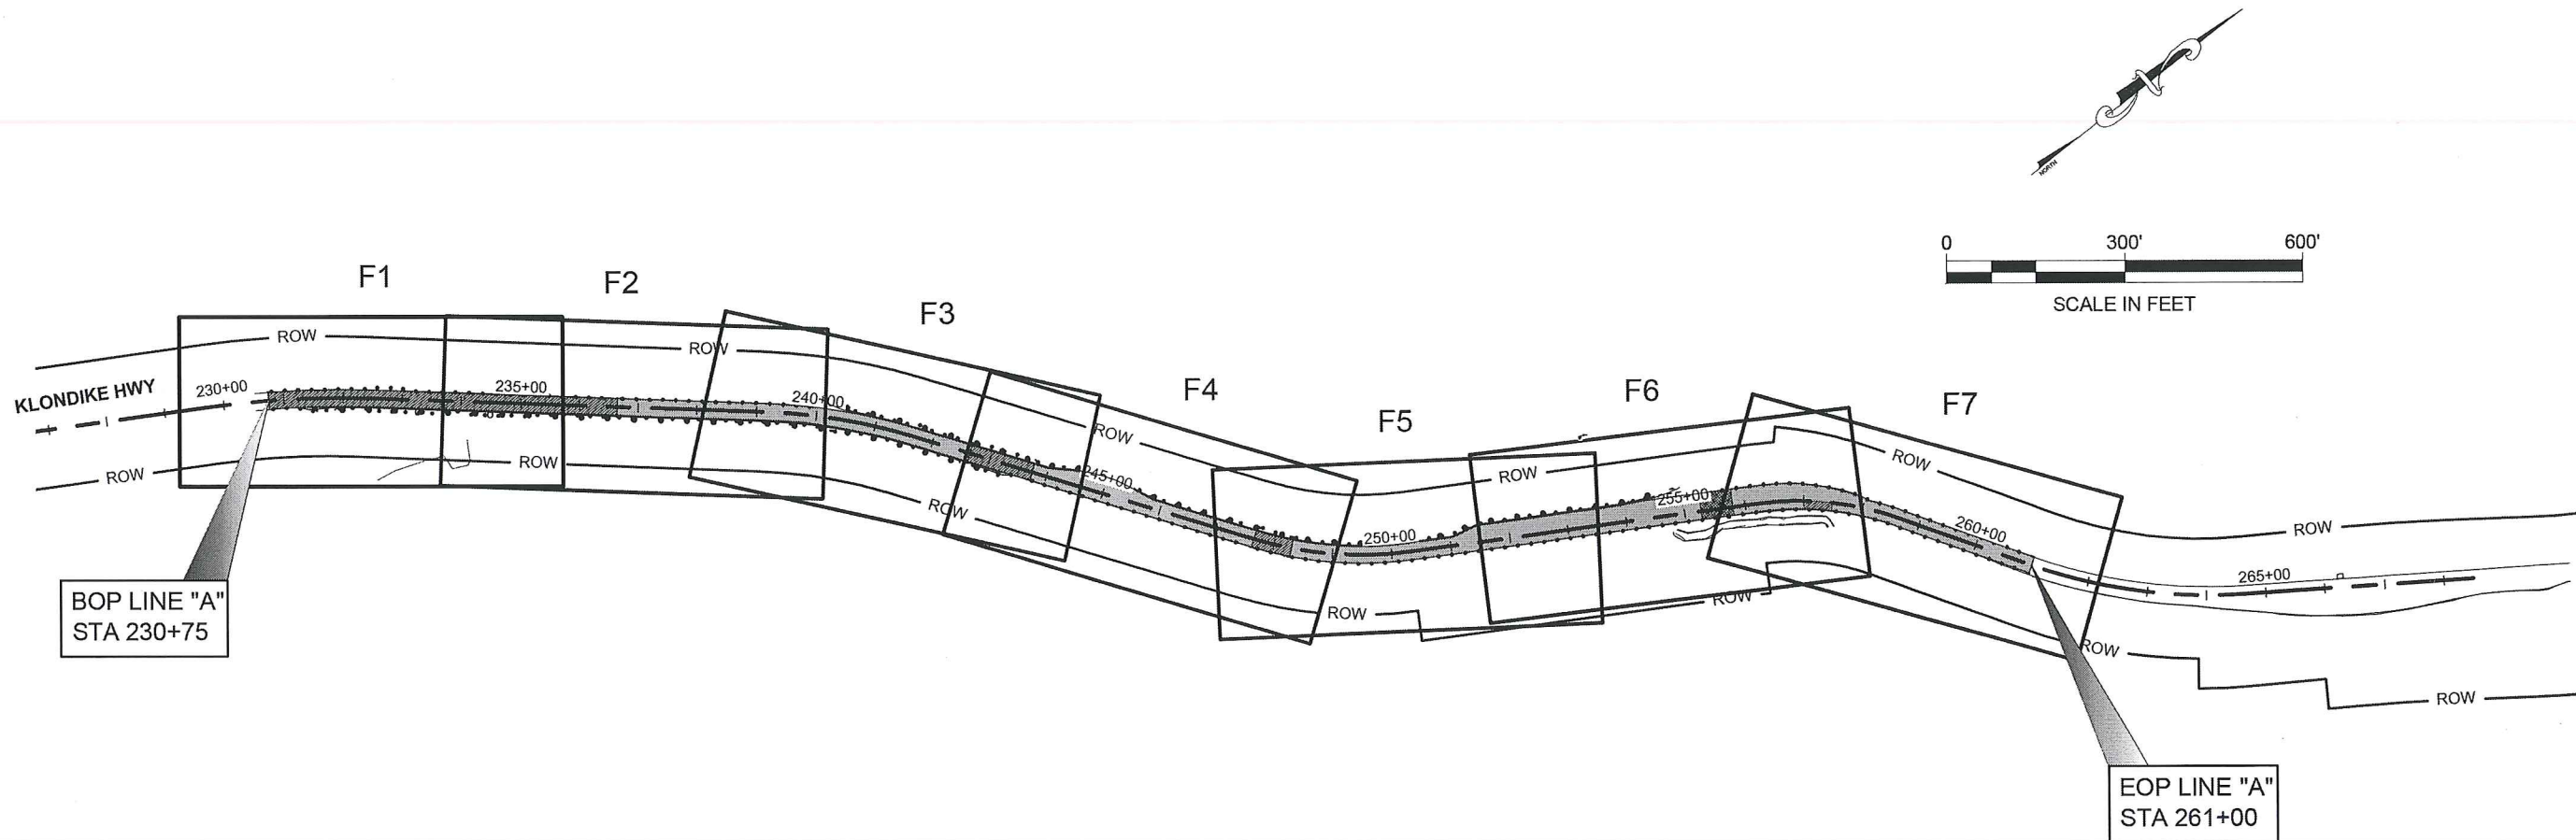

GENERAL NOTES:

1. ALL CONSTRUCTION WILL BE CONTAINED WITHIN THE RIGHT-OF-WAY. NO EXCESS MATERIAL SHALL BE DISPOSED OF WITHIN THE RIGHT-OF-WAY, UNLESS SPECIFICALLY CALLED FOR IN THE PLANS.
2. ALL PAVEMENT CUTS SHALL BE MADE WITH A SAW, OR ALTERNATE METHOD APPROVED BY THE ENGINEER.
3. PLACE BFM AND SEED ANY AREAS WITHIN THE RIGHT-OF-WAY DISTURBED BY CONSTRUCTION.
4. THERE SHALL BE NO PAYMENT FOR ADDITIONAL WORK CAUSED BY FAILURE TO ADJUST MONUMENTS TO FINAL GRADE.

Project As-Built Drawings have been reviewed
by the Project Engineer and represent to the
best of my knowledge the project as
constructed.





PE *[Signature]* Date 3-27-17




STATE OF ALASKA
DEPARTMENT OF TRANSPORTATION
AND PUBLIC FACILITIES
SGY: KLONDIKE HIGHWAY
REPAIRS
LAYOUT

DESIGNED: C. IVANISZEK
CHECKED: J. BROWN
DRAFTED: R. GRANTHAM
XREFS
SCALE
LAYOUT: A3
DATE/TIME: 9/11/2015 9:32
DRAWING LOCATION: Q:\Sgy\8480\Plans\8480_A3_Legend.dwg

NO.	DATE	REVISION	STATE	PROJECT DESIGNATION	YEAR	SHEET NO.	TOTAL SHEETS
			ALASKA	Z684800000~0972017	2015	A3	5

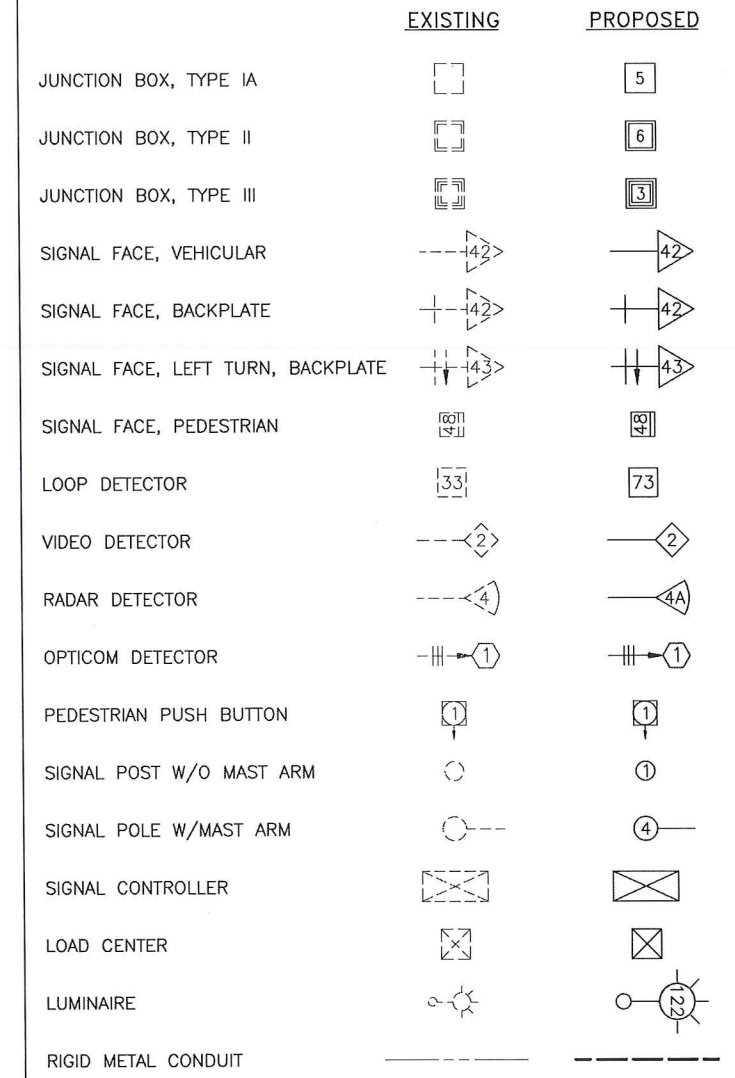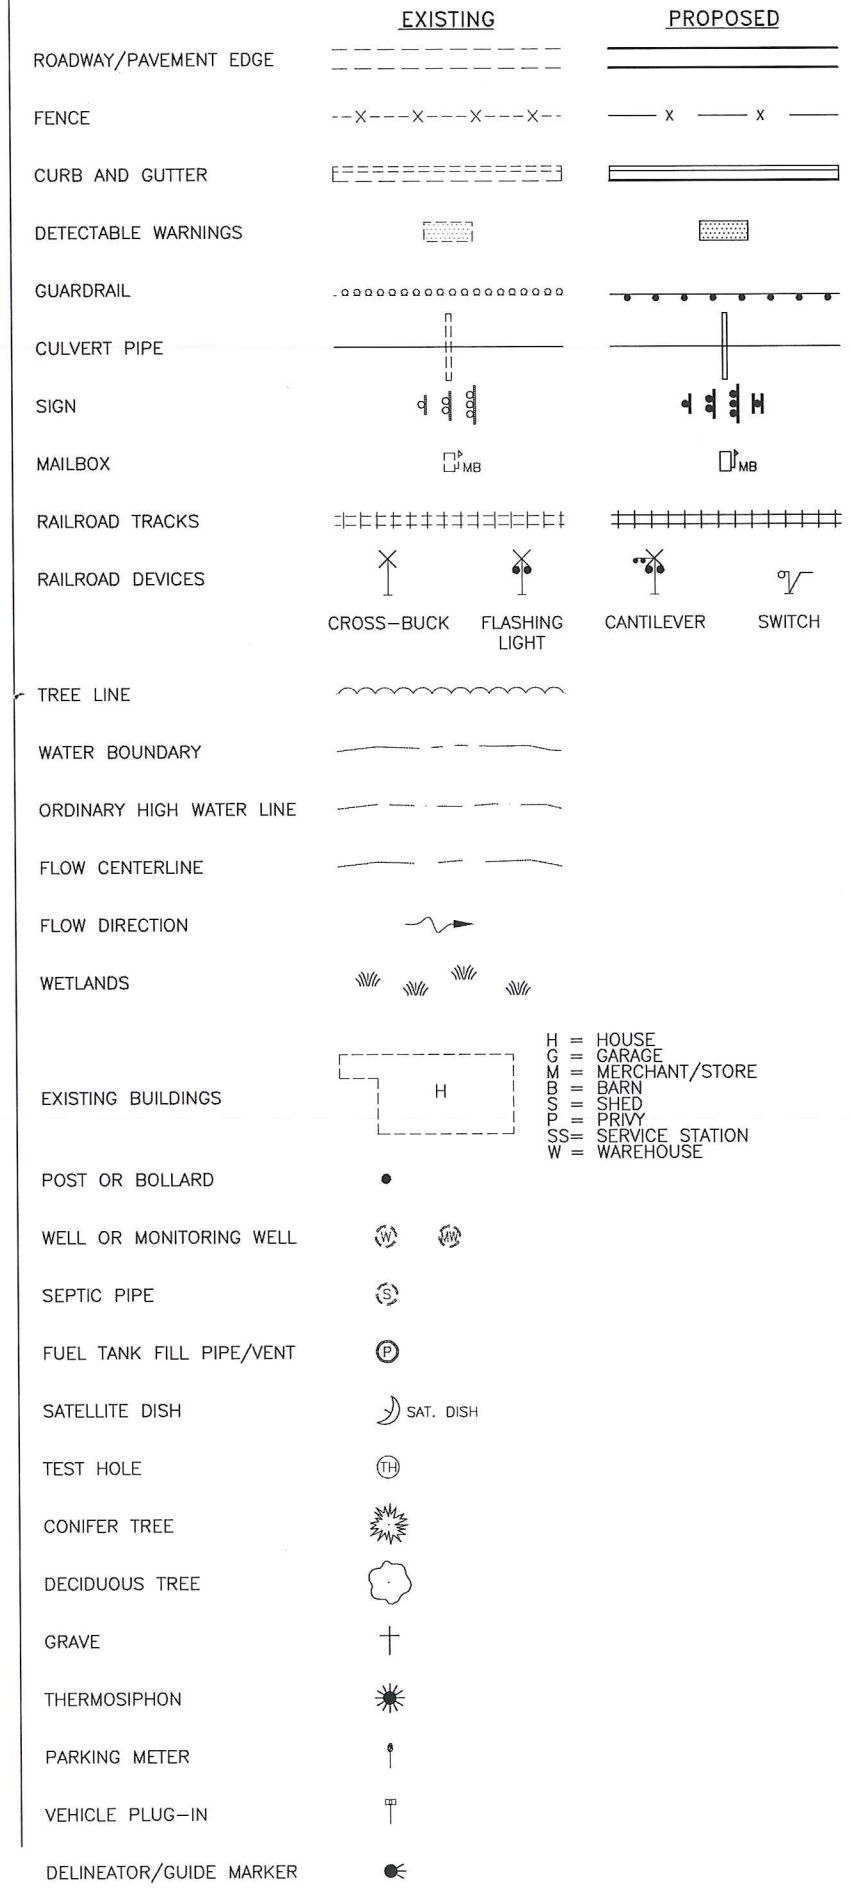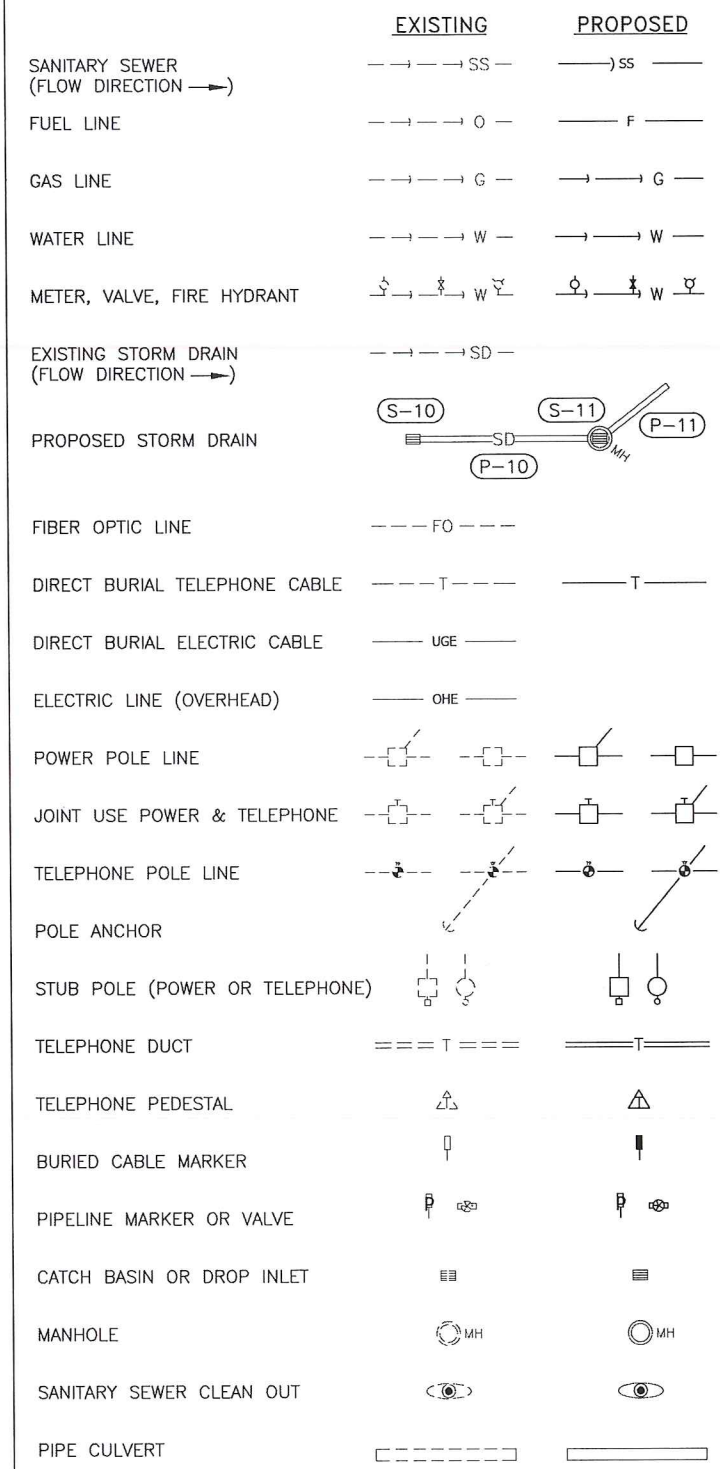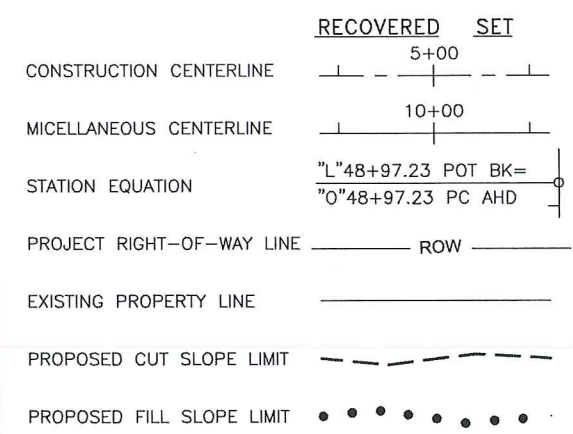

Project As-Built Drawings have been reviewed by the Project Engineer and represent to the best of my knowledge the project as constructed.

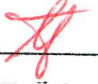PE  Date 3-27-17



STATE OF ALASKA
DEPARTMENT OF TRANSPORTATION
AND PUBLIC FACILITIES

SGY: KLONDIKE HIGHWAY
REPAIRS

LEGEND / SYMBOLS

DESIGNED: J. Papadimitrakopoulos
CHECKED: J. Papadimitrakopoulos
DRAWN: J. Papadimitrakopoulos
XREFS: SCALE: LAYOUT: A4
DATE: TIME: 8/25/2015 14:42
DRAWING LOCATION: C:\sg\68480\Plans\68480_A4-A5_Survey Ctrl.dwg

NO.	DATE	REVISION	STATE	PROJECT DESIGNATION	YEAR	SHEET NO.	TOTAL SHEETS
			ALASKA	Z684800000~0972017	2015	A4	5

KLONDIKE HIGHWAY DESIGN ALIGNMENT

SEGMENT	STATION	NORTHING	EASTING	DISTANCE	BEARING	STATION	RADIUS	LENGTH	DELTA
L1	225+83.20	2803268.95	2387739.37	393.23	N29° 53' 41"E	229+76.43			
C1	229+76.43	2803609.86	2387935.36			232+56.23	1620.00	279.79	9°53'45"
L2	232+56.23	2803839.21	2388095.01	657.91	N39° 47' 26"E	239+14.14			
C2	239+14.14	2804344.74	2388516.06			241+62.28	970.00	248.15	14°39'27"
L3	241+62.28	2804513.13	2388697.40	606.56	N54° 26' 53"E	247+68.84			
C3	247+68.84	2804865.81	2389190.89			250+32.24	620.00	263.40	24°20'31"
L4	250+32.24	2805059.24	2389366.76	589.33	N30° 06' 22"E	256+21.57			
C4	256+21.57	2805569.07	2389662.37			258+63.75	510.00	242.18	27°12'28"
L5	258+63.75	2805742.49	2389828.15	231.04	N57° 18' 50"E	260+94.79			
C5	260+94.79	2805867.26	2390022.60			264+67.17	910.00	372.38	23°26'46"
L6	264+67.17	2806126.03	2390286.76	382.78	N33° 52' 04"E	268+49.95			

All coordinates, distances, and bearings shown hereon are NAD83(2011) Epoch 2010.00 Alaska State Plane Zone 1 Grid. The computed Combined Scale Factor for this project is 0.99998438. To obtain ground distances from Grid distances divide ground distance by the computed Combined Scale Factor.

The vertical datum for this project is NAVD88 derived from ties to the National Spatial Reference System and applying N.G.S. Geoid model 12A to the resultant ellipsoidal heights.

Survey Control Table						
Point #	Northing	Easting	Elevation	Description	Station	Offset
103	2803648.33	2387937.81	551.62	GPS_ALCAP2" _SET	230+10.64	17.42L
104	2804423.94	2388566.16	543.50	GPS_ALCAP2" _SET	240+05.63	16.58L
108	2804928.19	2389287.49	544.32	ALCAP2" _SET	248+81.45	15.87R
1004	2806627.49	2390647.12	587.19	ALCAP2" _DOT_SET	N\A	N\A
1007	2804483.94	2388687.78	539.31	ALCAP2" _DOT_SET	241+37.01	17.83R

All **SURVEY CONTROL** monuments in this table are provided strictly for survey control. Should any of them be destroyed during construction they **shall NOT** be replaced.

2" ALCAP ON 36" X 5/8" REBAR SET THIS SURVEY



Centerline Monuments					
Point #	Northing	Easting	Description	Station	Offset
1001	2805060.16	2389366.94	BC2" _FND _DOH _IN -CASE	250+33.13	0.30L
1002	2805666.84	2389719.99	BC2" _FND _IN -CASE	257+33.41	11.69L
1003	2805987.08	2390193.25	BC2" _FND _IN -CASE	263+01.50	15.07R
1006	2806824.74	2390711.20	BC2.5" _DOH _272+87 _FND	N\A	N\A
1008	2806568.37	2390583.31	CL_MON_BOX_FND_NO_MON	N\A	N\A

All **CENTERLINE MONUMENTS** in this **existing centerline** table shall be **preserved** or **referenced** prior to disturbance and replaced at their original horizontal position.

2.5" BRASS CAP IN WELL CASE RECOVERED THIS SURVEY



MONUMENT NOTES:

1. If any pair of control points disagrees from published value by more than 1:10,000 horizontally or vertically then a third network point must be tied to ascertain which point is in error or has been disturbed.

2. Whether listed or not, all monuments, property markers, or accessories that will be disturbed or buried shall be referenced prior to being disturbed, and re-established in their original position and a record of monument form in accordance with A.S.34.65.040 shall be submitted to the construction engineer for review prior to recording. Coordinate values listed are for informational purposes and should be used to reset monuments only as a last resort.

Project As-Built Drawings have been reviewed by the Project Engineer and represent to the best of my knowledge the project as constructed.

PE  Date 3-27-17




STATE OF ALASKA
DEPARTMENT OF TRANSPORTATION
AND PUBLIC FACILITIES

SGY: KLONDIKE HIGHWAY
REPAIRS

SURVEY CONTROL

DESIGNED: J. Papadimitriou
CHECKED: J. Papadimitriou
DRAFTED: J. Papadimitriou
XREFS: SCALE: LAYOUT: A5
DATE: TIME: 8/25/2015 14:42
DRAWING LOCATION: C:\Users\j.papadimitriou\OneDrive\Documents\68480_A4-A5_Survey_Ctrl.dwg



NO.	DATE	REVISION	STATE	PROJECT DESIGNATION	YEAR	SHEET NO.	TOTAL SHEETS
			ALASKA	Z684800000~0972017	2015	A5	5

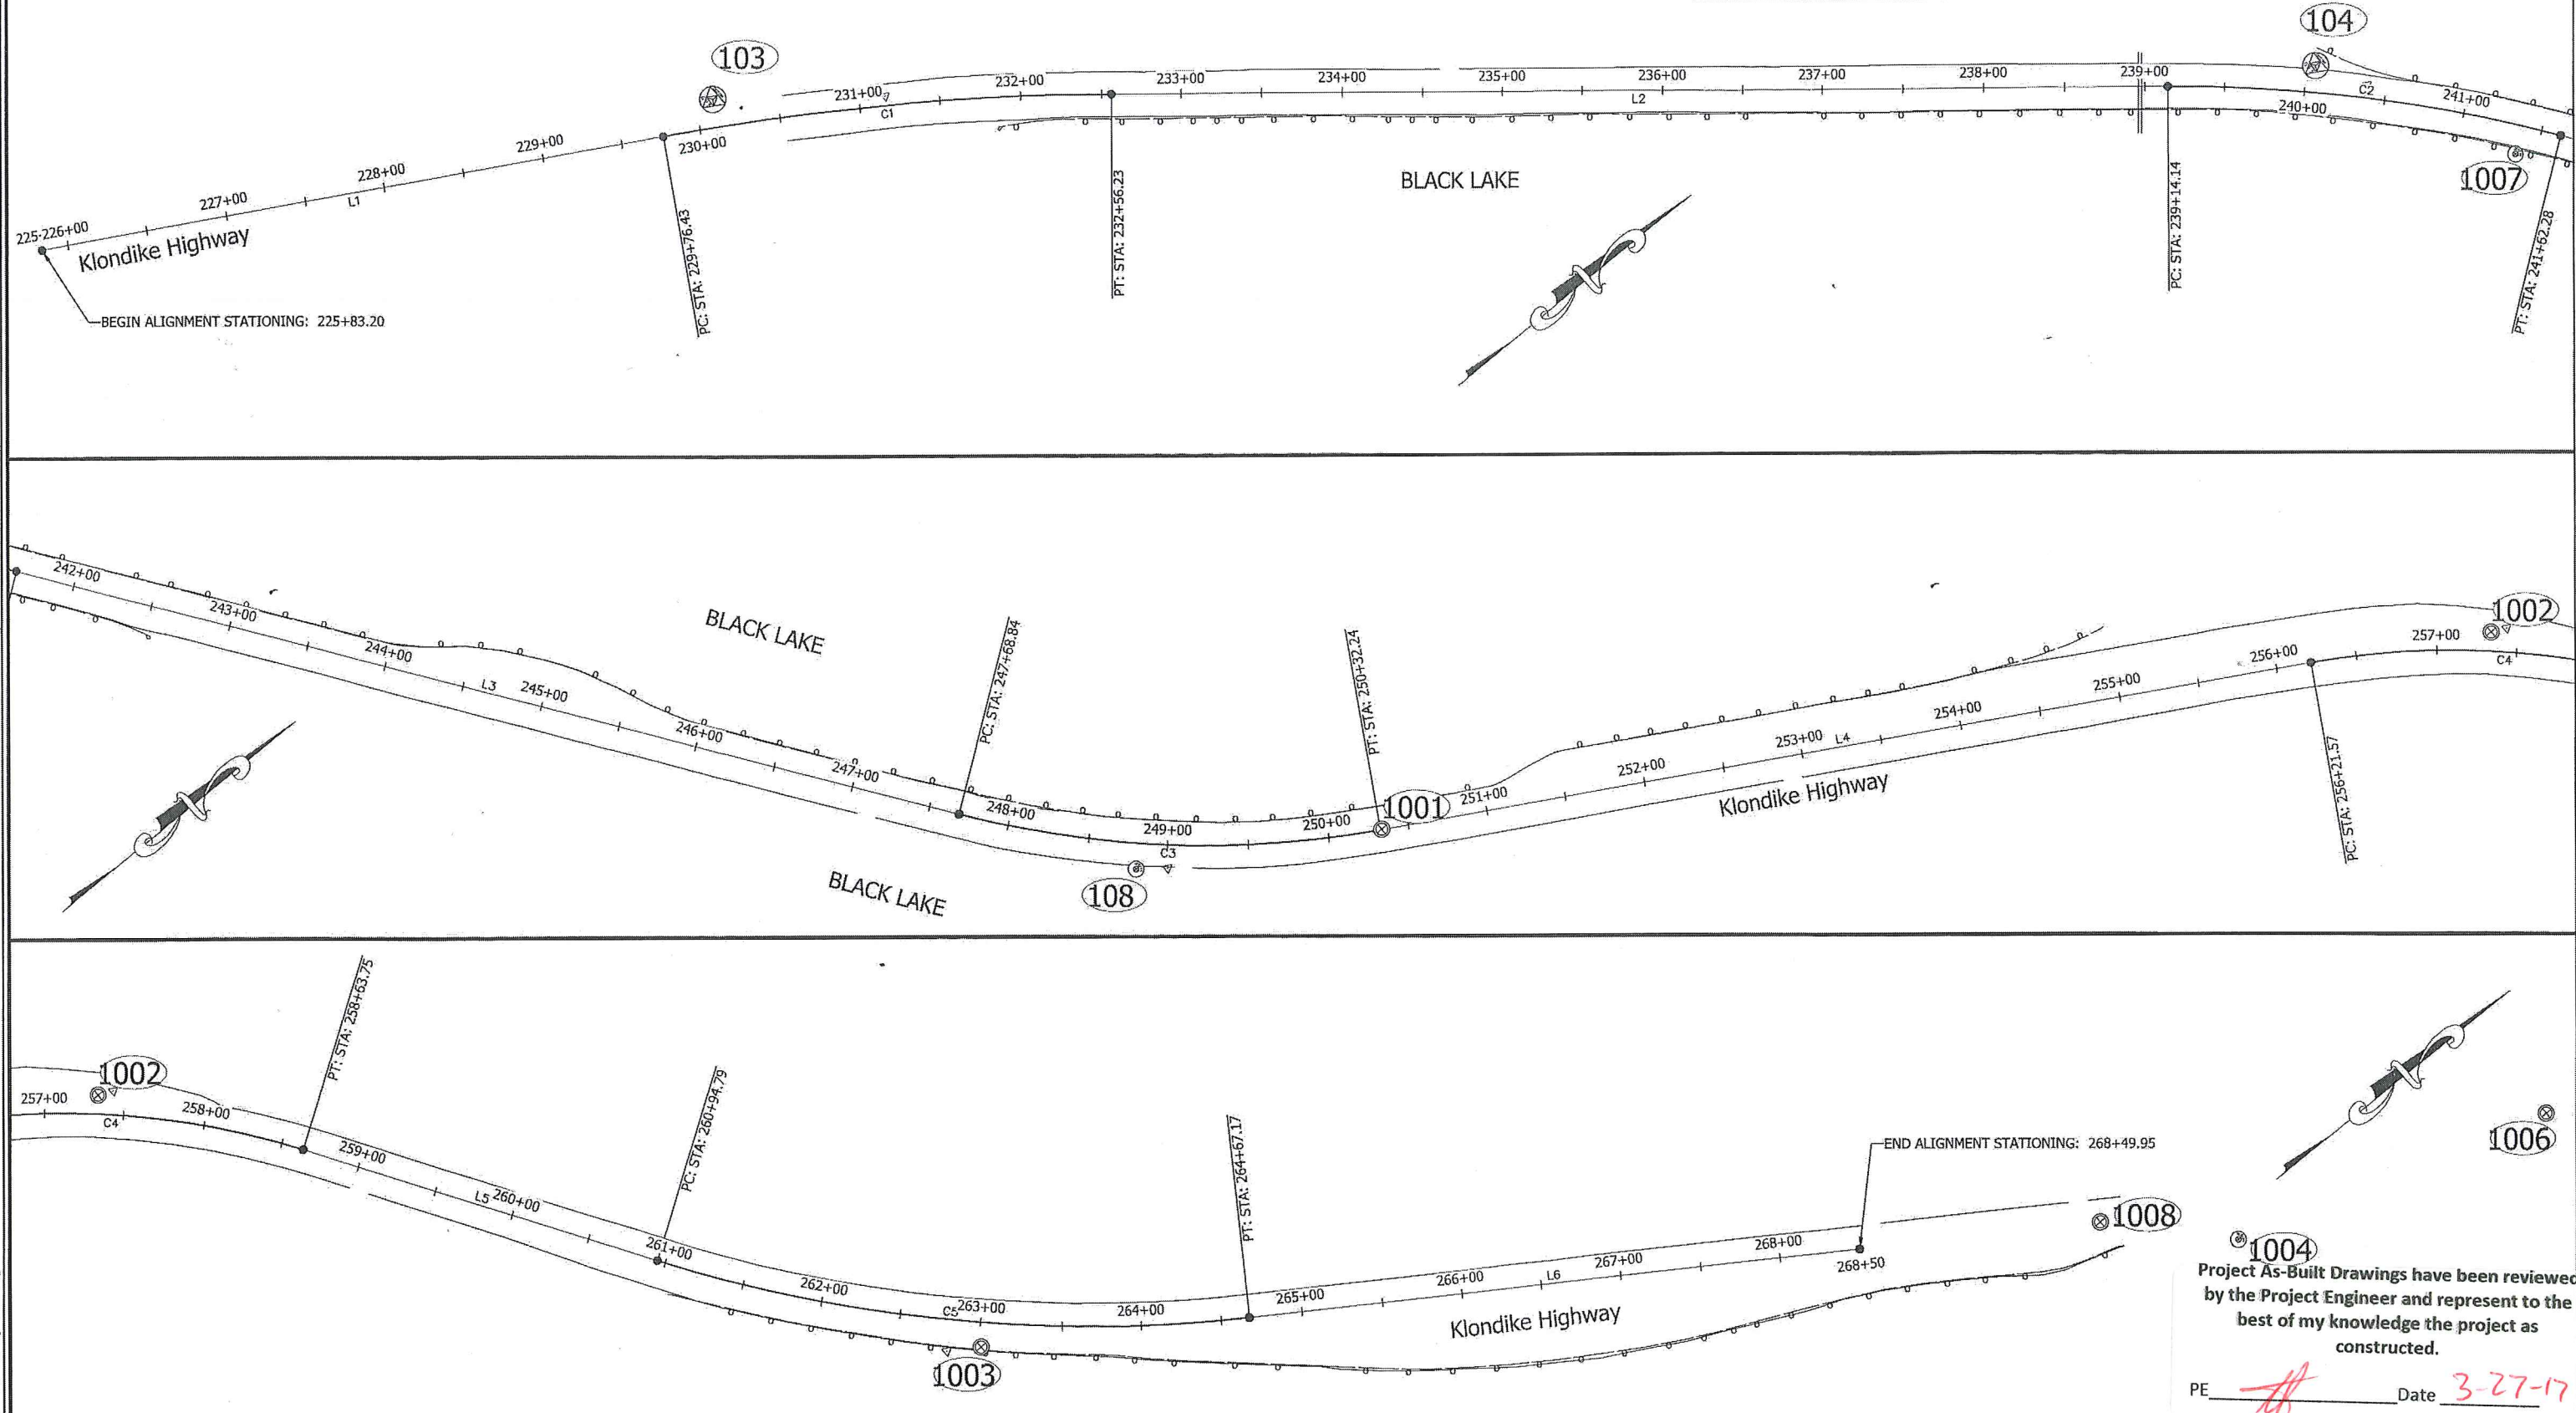


MONUMENT NOTES:

1. If any pair of control points disagrees from published value by more than 1:10,000 horizontally or vertically then a third network point must be tied to ascertain which point is in error or has been disturbed.

2. Whether listed or not, all monuments, property markers, or accessories that will be disturbed or buried shall be referenced prior to being disturbed, and re-established in their original position and a record of monument form in accordance with A.S.34.65.040 shall be submitted to the construction engineer for review prior to recording. Coordinate values listed are for informational purposes and should be used to reset monuments only as a last resort.

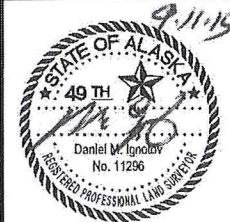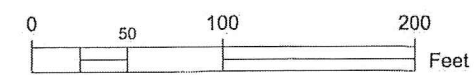

Project As-Built Drawings have been reviewed by the Project Engineer and represent to the best of my knowledge the project as constructed.

PE  Date 3-27-17

STATE OF ALASKA
DEPARTMENT OF TRANSPORTATION
AND PUBLIC FACILITIES
SGY: KLONDIKE HIGHWAY
REPAIRS

SURVEY CONTROL

DESIGNED: C. IVANISZEK
CHECKED: J. BROWN
DRAFTED: R. GRANTHAM


SCALE

LAYOUT B1


DATE TIME 8/25/2015 11:47

DRAWING LOCATION Q:\SGY\68400\Plns\B1-B2_TYP.dwg

NO.	DATE	REVISION	STATE	PROJECT DESIGNATION	YEAR	SHEET NO.	TOTAL SHEETS
			ALASKA	Z684800000~0972017	2015	B1	2

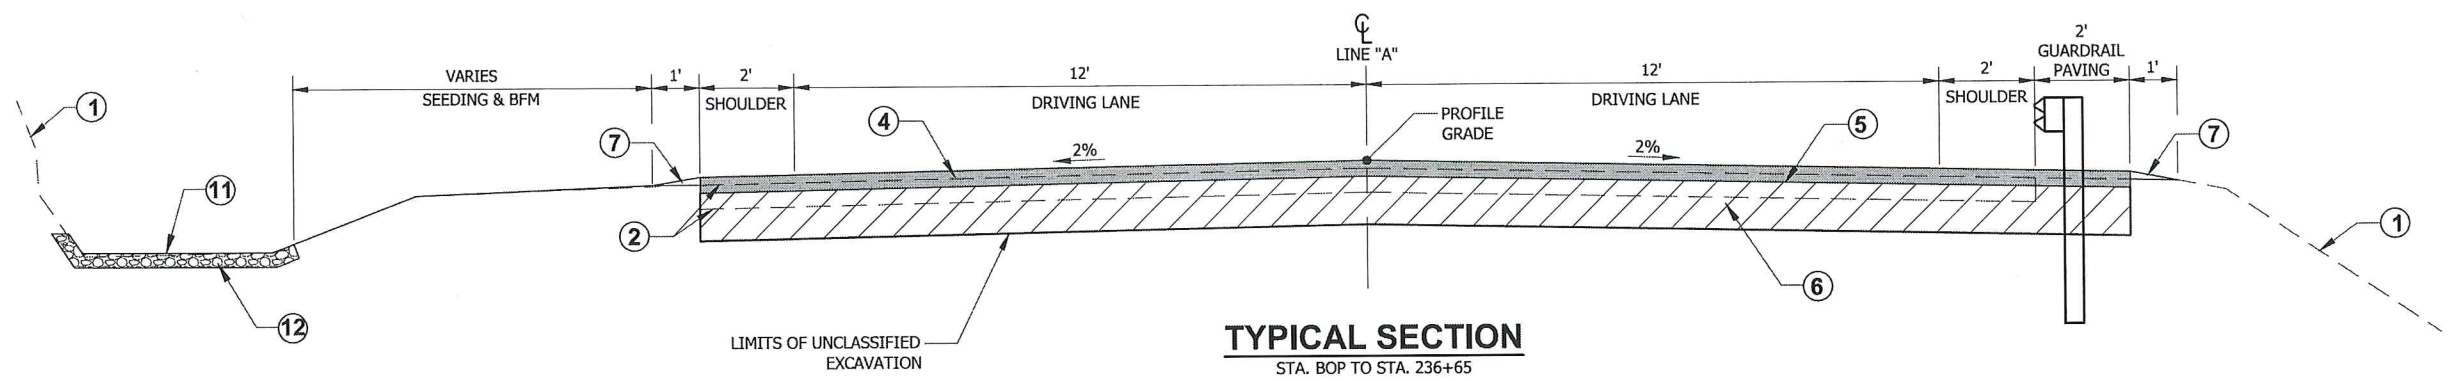

TYPICAL SECTION
STA. BOP TO STA. 236+65

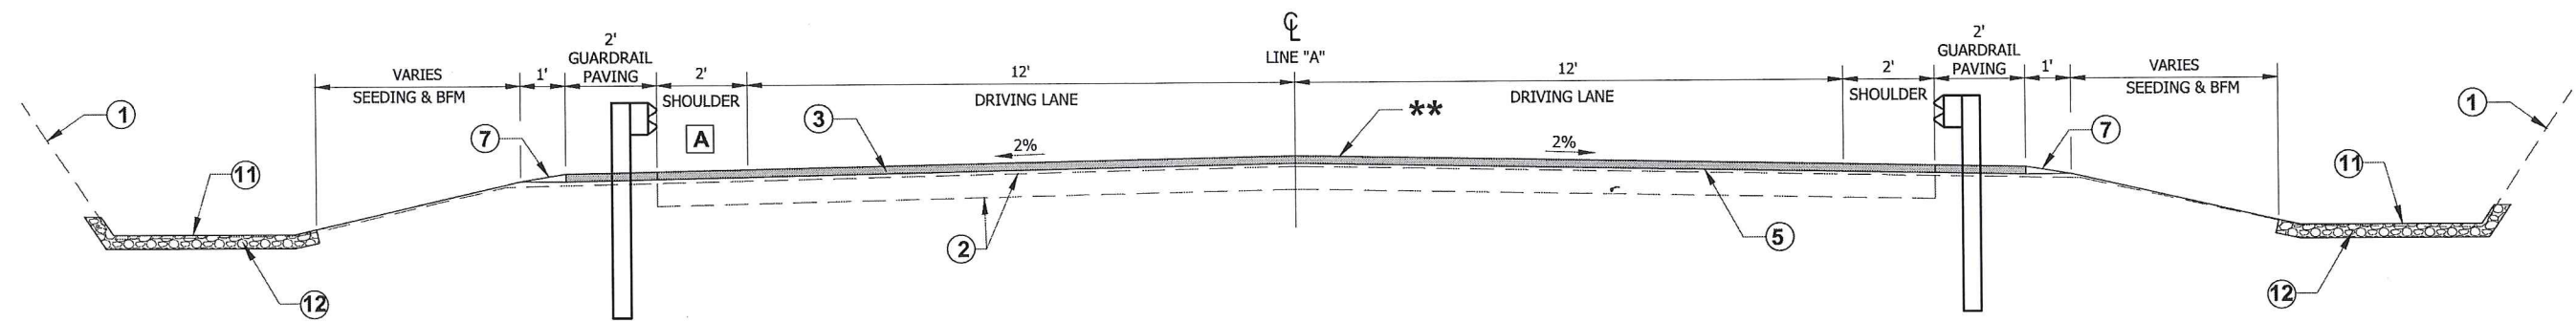


TYPICAL SECTION
STA. 236+65 TO STA. 242+65
STA. 243+75 TO STA. 247+65
STA. 248+30 TO EOP

- A** SHOULDER WIDTH VARIES:
- 2' TO 28' FROM STA. 243+99 TO STA. 245+86 LT
 - 2' TO 28' FROM STA. 251+03 TO STA. 258+09 LT

****** PRELEVELING REQUIRED FROM STA. 255+27 TO STA. 255+80

LEGEND

- 1 ORIGINAL GROUND
- 2 EXISTING PAVEMENT (THICKNESS VARIES 4"-8")
- 3 2" HMA OVERLAY, TYPE II, CLASS B
- 4 4" HMA, TYPE II, CLASS B (2 LIFTS WITH STE-1 TACK COAT BETWEEN LIFTS)
- 5 STE-1 TACK COAT
- 6 12" AGGREGATE BASE COURSE, GRADING D-1
- 7 LINEAR GRADING
- 8 2" SUBBASE, GRADING A (1' LIFTS WITH TRIAXIAL GEOGRID)
- 9 TRIAXIAL GEOGRID
- 10 W-BEAM GUARDRAIL
- 11 DITCH RECONDITIONING TO 1' ABOVE FLOW LINE
- 12 DITCH LINING

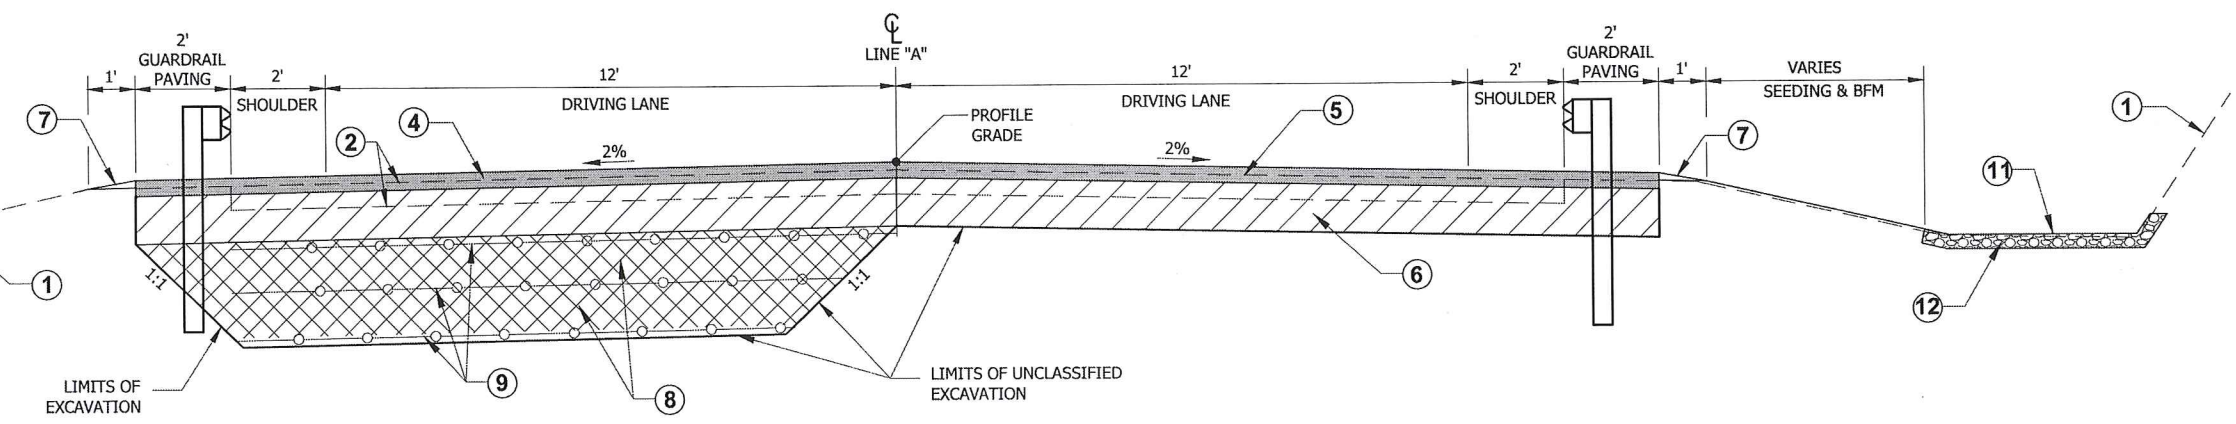

TYPICAL SECTION
STA. 242+65 TO STA. 243+75
STA. 247+65 TO STA. 248+30

TYPICAL SECTION NOTES:

- WHERE VOIDS ARE UNCOVERED - CLOSE OFF VOIDS USING GEOTEXTILE STABILIZATION & BACKFILL WITH SUBBASE, GRADING A. SEE SHEET B2 FOR VOID REPAIR TYPICAL SECTION.
- STABILIZE ALL NEW EMBANKMENT SLOPES WITH SEEDING AND BFM PER SECTIONS 618 AND 619.

Project As-Built Drawings have been reviewed by the Project Engineer and represent to the best of my knowledge the project as constructed.

PE *[Signature]* Date 3-27-17




STATE OF ALASKA
DEPARTMENT OF TRANSPORTATION
AND PUBLIC FACILITIES

SGY: KLONDIKE HIGHWAY
REPAIRS

TYPICAL SECTIONS


DESIGNED: C. VANISZEK
CHECKED: J. BROWN
DRAFTED: R. GRANTHAM
XREFS
SCALE
LAYOUT: B2
DATE/TIME: 8/25/2015 11:47
DRAWING LOCATION: Q:\Sg\168480\Plan\set168480_B1-B2_TYP.dwg

NO.	DATE	REVISION	STATE	PROJECT DESIGNATION	YEAR	SHEET NO.	TOTAL SHEETS
			ALASKA	Z684800000~0972017	2015	B2	2

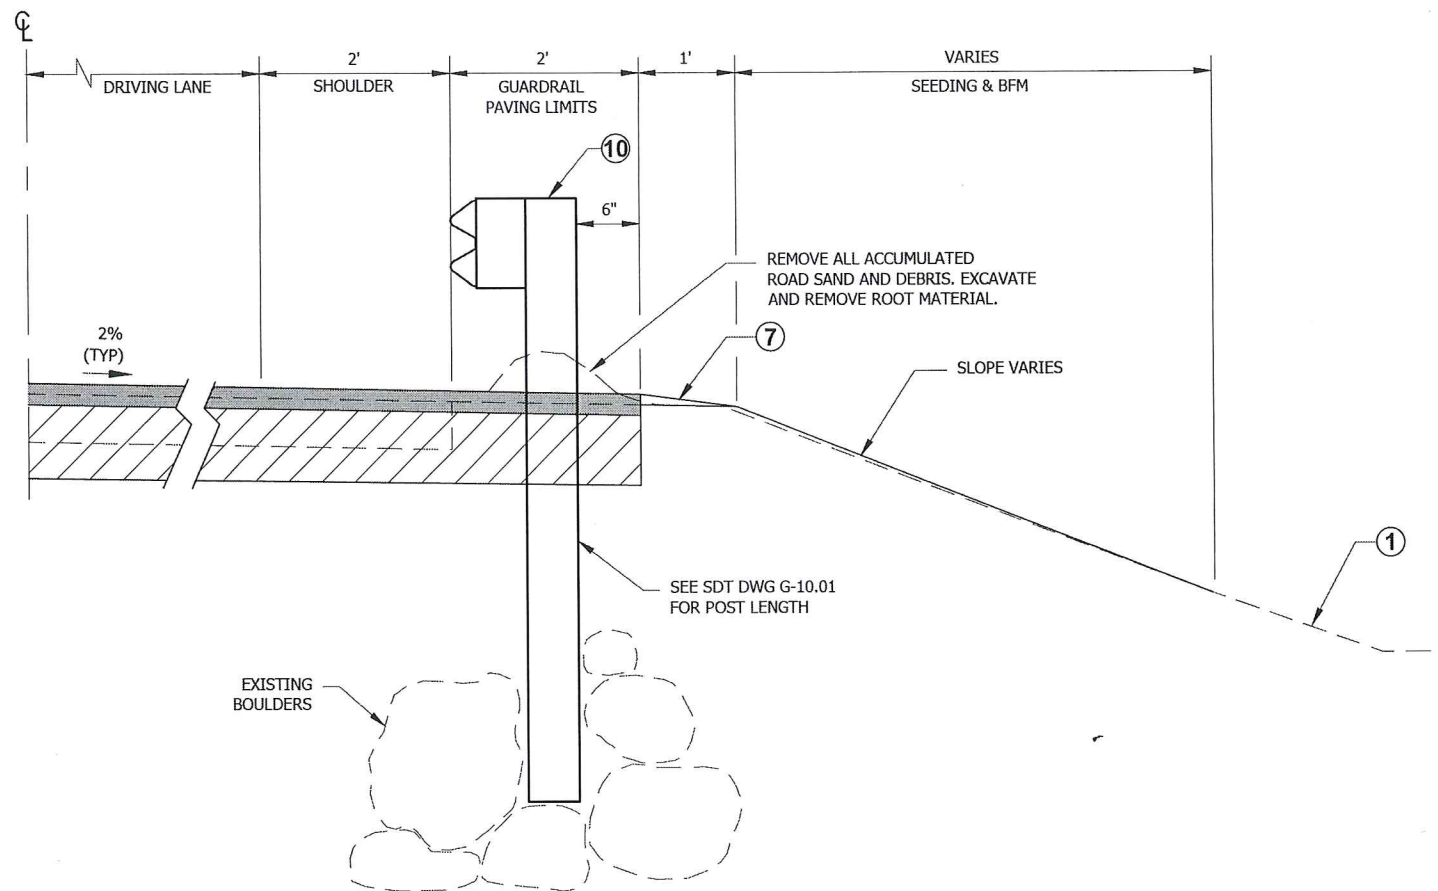


TYPICAL SECTION GUARDRAIL PAVING

STA. 231+59 RT TO STA. 243+11 RT
STA. 240+05 LT TO STA. 254+97 LT

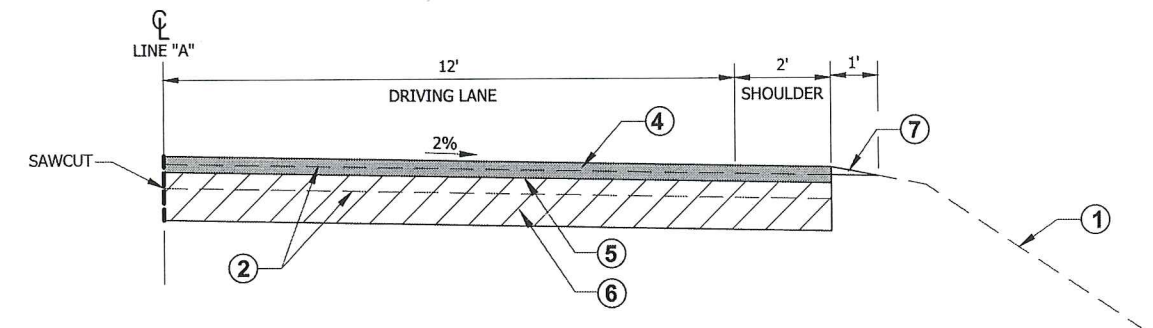

TYPICAL SECTION

STA. 257+00 TO STA. 257+48 RT

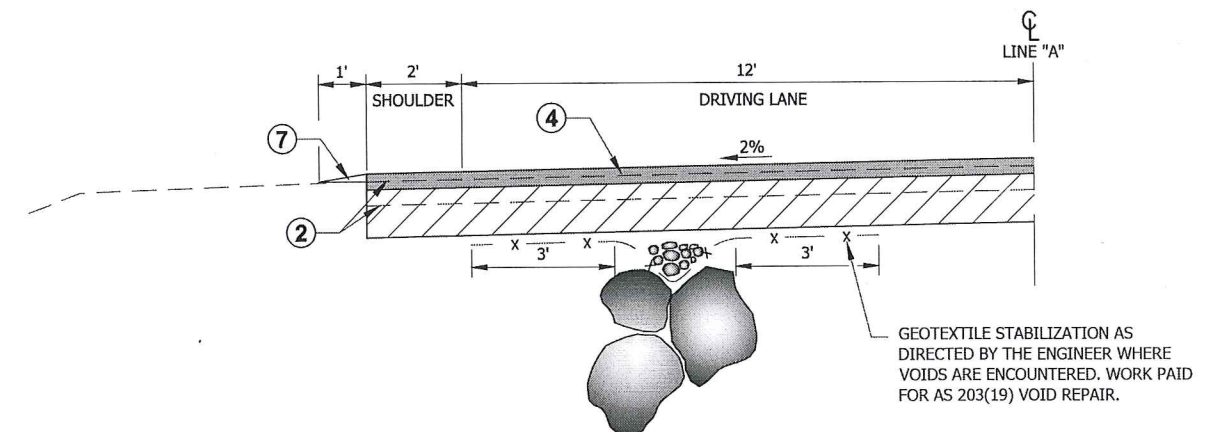

TYPICAL SECTION VOID REPAIR


NTS

LEGEND

- ① ORIGINAL GROUND
- ② EXISTING PAVEMENT (THICKNESS VARIES 4"-8")
- ③ 2" HMA OVERLAY, TYPE II, CLASS B
- ④ 4" HMA, TYPE II, CLASS B (2 LIFTS WITH STE-1 TACK COAT BETWEEN LIFTS)
- ⑤ STE-1 TACK COAT
- ⑥ 12" AGGREGATE BASE COURSE, GRADING D-1
- ⑦ LINEAR GRADING
- ⑧ 2' SUBBASE, GRADING A (1' LIFTS WITH TRIAXIAL GEOGRID)
- ⑨ TRIAXIAL GEOGRID
- ⑩ W-BEAM GUARDRAIL
- ⑪ DITCH RECONDITIONING TO 1' ABOVE FLOW LINE
- ⑫ DITCH LINING

Project As-Built Drawings have been reviewed
by the Project Engineer and represent to the
best of my knowledge the project as
constructed.

PE *[Signature]* Date **3-27-18**

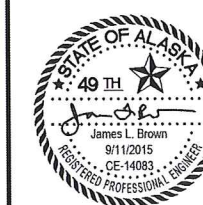

STATE OF ALASKA
DEPARTMENT OF TRANSPORTATION
AND PUBLIC FACILITIES

SGY: KLONDIKE HIGHWAY
REPAIRS

TYPICAL SECTIONS

202(2) REMOVAL OF PAVEMENT			
STATION TO STATION		AREA (SY)	REMARKS
BOP	236+65	1836	Existing Pavement Approximately 8" Thick
242+65	243+75	342	Existing Pavement Approximately 6" Thick
247+65	248+30	202	Existing Pavement Approximately 8" Thick
257+00	257+48	70	Existing Pavement Approximately 8" Thick
TOTAL =		2450	

202(4) CULVERT REMOVAL				
STATION	TYPE	DIAMTER (IN)	LENGTH (FT)	REMARKS
238+97	CSP	24"	50	
242+02	CSP	48"	61	
254+50	CSP	48"	101	
256+67	CSP	24"	77	
Total =			289	

303(4) DITCH RECONDITIONING				
STATION TO STATION		OFFSET	LENGTH	REMARKS
230+85	239+90	LT	905	
242+61	254+76	RT	1215	1270
257+62	261+00	LT	338	255
		TOTAL =	2458	2408

401(17) PRELEVEL FOR RUTS, DELAMINATIONS AND DEPRESSIONS		
STATION TO STATION		REMARKS
255+27	255+80	260
TOTAL =		260 DELETED by P.B.

603 PIPE SUMMARY									
PIPE NUMBER	603(9-24)		INLET			OUTLET			REMARKS
	24" CAP	48" CAP	STATION	OFFSET	INV.	STATION	OFFSET	INV.	
P-1	50		238+97	20.94 LT	541.40	238+96	26.87 RT	539.04	INLCUDE THAW WIRE INSTALLATION PER STD. DWG D-14.10
P-2		61	241+89	25.50 RT	533.13	242+17	28.17 LT	530.80	INLCUDE THAW WIRE INSTALLATION PER STD. DWG D-14.10
P-3		101	254+07	40.39 LT	531.97	254+82	27.87 RT	529.29	INLCUDE THAW WIRE INSTALLATION PER STD. DWG D-14.10
P-4	82		256+75	52.71 LT	529.71	256+61	27.50 RT	527.11	INLCUDE THAW WIRE INSTALLATION PER STD. DWG D-14.10
TOTAL	132	162							

NO.	DATE	REVISION	STATE	PROJECT DESIGNATION	YEAR	SHEET NO.	TOTAL SHEETS
			ALASKA	Z684800000~0972017	2015	D1	1

606(1) W-BEAM GUARDRAIL				
STATION TO STATION		OFFSET	RUN	REMARKS
231+97	242+73	RT	1076	1066
240+05	254+97	LT	1492	Install Downstream End Anchors at STA 240+14 & STA 254+87 LT
		TOTAL =	2568	2550

606(6) REMOVING AND DISPOSING OF GUARDRAIL				
STATION TO STATION		OFFSET	RUN	REMARKS
231+85	242+54	RT	1069	
240+05	256+97	LT	1692	
		TOTAL =	2761	

606(13) PARALLEL GUARDRAIL TERMINAL				
STATION		OFFSET	LENGTH (FT)	REMARKS
231+47	RT	50.0	231+45	
243+23	RT	50.0	243+20	

642(4) SET PRIMARY MONUMENT 642(6) REFERENCE EXISTING MONUMENT 642(10) MONUMENT CASE			
STATION	OFFSET (FT)	POINT #	REMARKS
250+33.13	0.30 LT	1001	SEE SHEET A4
257+33.41	11.69 LT	1002	SEE SHEET A4

* SEE SHEET E1 FOR SLOPE INDICATOR AND PIEZOMETER MONUMENT CASE DETAIL & LOCATIONS.

629(1) GUARDRAIL PAVING			
STATION TO STATION		OFFSET	REMARKS
231+25	243+44	RT	1219
239+90	255+06	LT	1516
		TOTAL =	2735


Project As-Built Drawings have been reviewed
by the Project Engineer and represent to the
best of my knowledge the project as
constructed.

PE  Date 3-27-17




STATE OF ALASKA
DEPARTMENT OF TRANSPORTATION
AND PUBLIC FACILITIES
SGY: KLONDIKE HIGHWAY
REPAIRS
SUMMARIES


DESIGNED C. IVANISZEK	CHECKED J. BROWN	DRAFTED R. GRANTHAM
XREFS		
SCALE		
LAYOUT E1		
DATE TIME 10/6/2015 13:37		
DRAWING LOCATION Q:\Sgy\8480\Plans\6480_E1_Misc Dets.dwg		

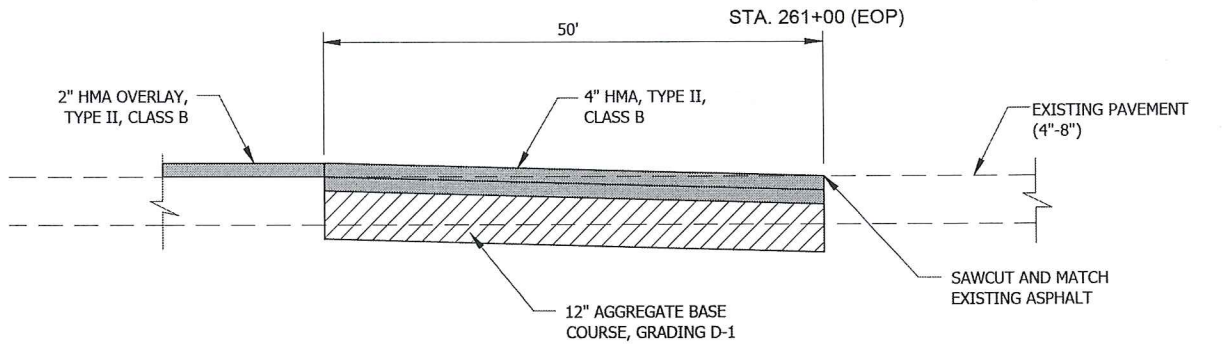


PAVEMENT TRANSITION DETAIL
N.T.S.

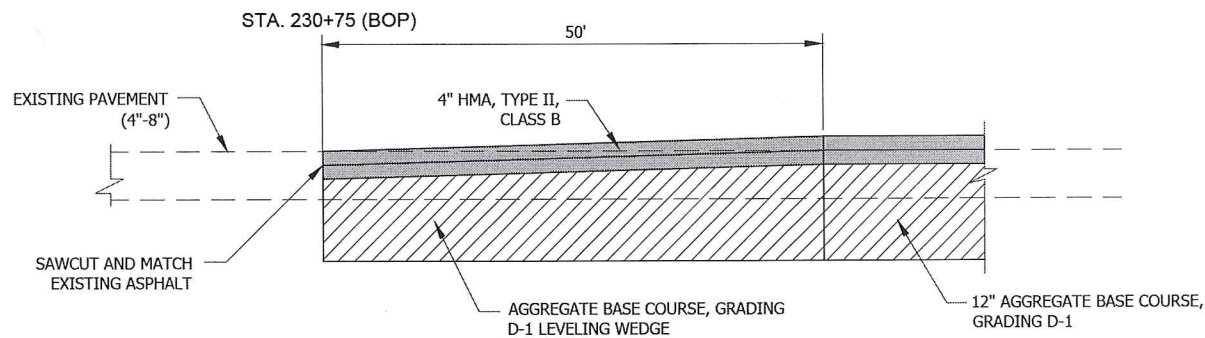


PAVEMENT TRANSITION DETAIL
N.T.S.

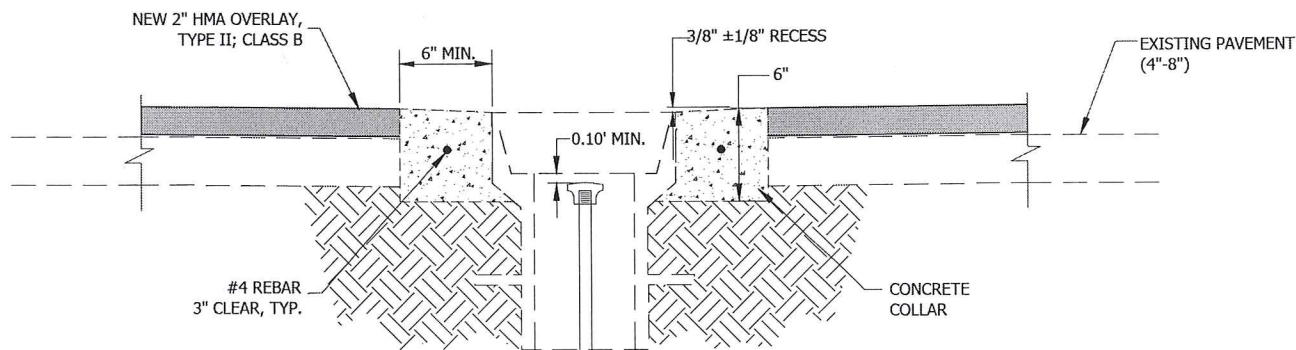

MONUMENT CASE DETAIL
N.T.S.

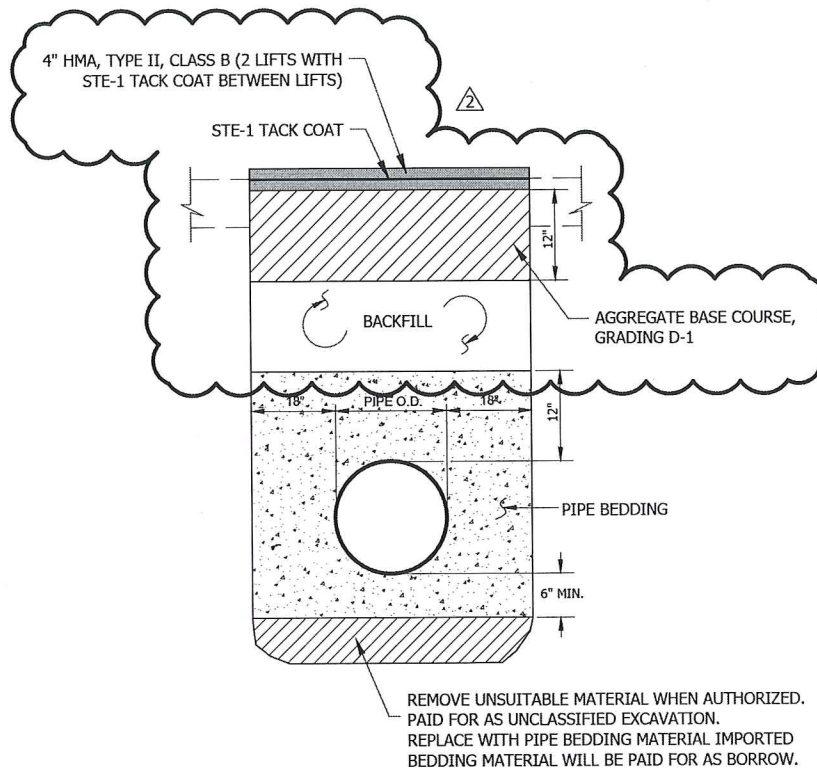

CULVERT BEDDING/BACKFILL DETAIL
N.T.S.

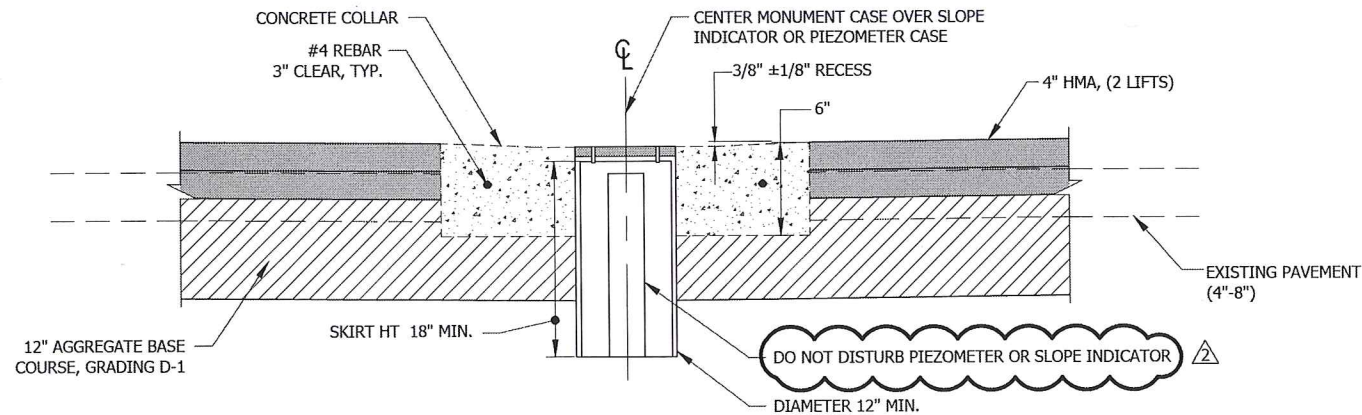

SLOPE INDICATOR & PIEZOMETER MONUMENT CASE DETAIL

- STA. 232+75, OFFSET: 3.73' RT
- STA. 233+26, OFFSET: 3.84' RT
- STA. 255+58, OFFSET: 23.48' LT



NOTES:

1. REMOVE EXISTING MONUMENT CASE AND REPLACE AS SHOWN.
2. LID SHALL BE CAST IRON, BOLT DOWN AND WATER TIGHT.

Project As-Built Drawings have been reviewed by the Project Engineer and represent to the best of my knowledge the project as constructed.

PE *[Signature]* Date 3-27-17

NO.	DATE	REVISION	STATE	PROJECT DESIGNATION	YEAR	SHEET NO.	TOTAL SHEETS
2	10/6/15	ADDENDUM NO.2	ALASKA	Z684800000~0972017	2015	E1	3

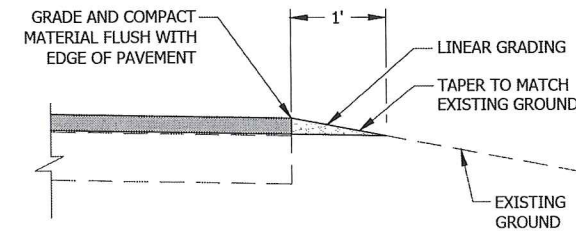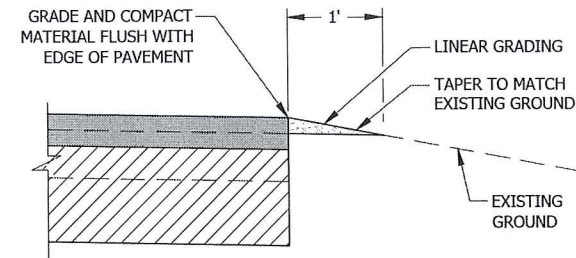

LINEAR GRADING
LEFT AND RIGHT EDGE OF PAVEMENT

NOTES:

1. MATERIAL FOR LINEAR GRADING SHALL MEET THE REQUIREMENTS AS SPECIFIED IN SECTION 303 OF THE SPECIAL PROVISIONS.
2. LINEAR GRADING SHALL BE PAID FOR UNDER ITEM 303(3).



STATE OF ALASKA
DEPARTMENT OF TRANSPORTATION
AND PUBLIC FACILITIES
SGY: KLONDIKE HIGHWAY
REPAIRS
MISCELLANEOUS
DETAILS

DESIGNED: C. IVANISZEK
CHECKED: J. BROWN
DRAFTED: R. GRANTHAM

XREFS

SCALE

LAYOUT



DATE TIME

8/25/2015 11:50

DRAWING LOCATION


Q:\Sg\98480\Plan\Set68480_E2-E3_Misc Dets.dwg

NO.	DATE	REVISION	STATE	PROJECT DESIGNATION	YEAR	SHEET NO.	TOTAL SHEETS
			ALASKA	Z684800000~0972017	2015	E2	3

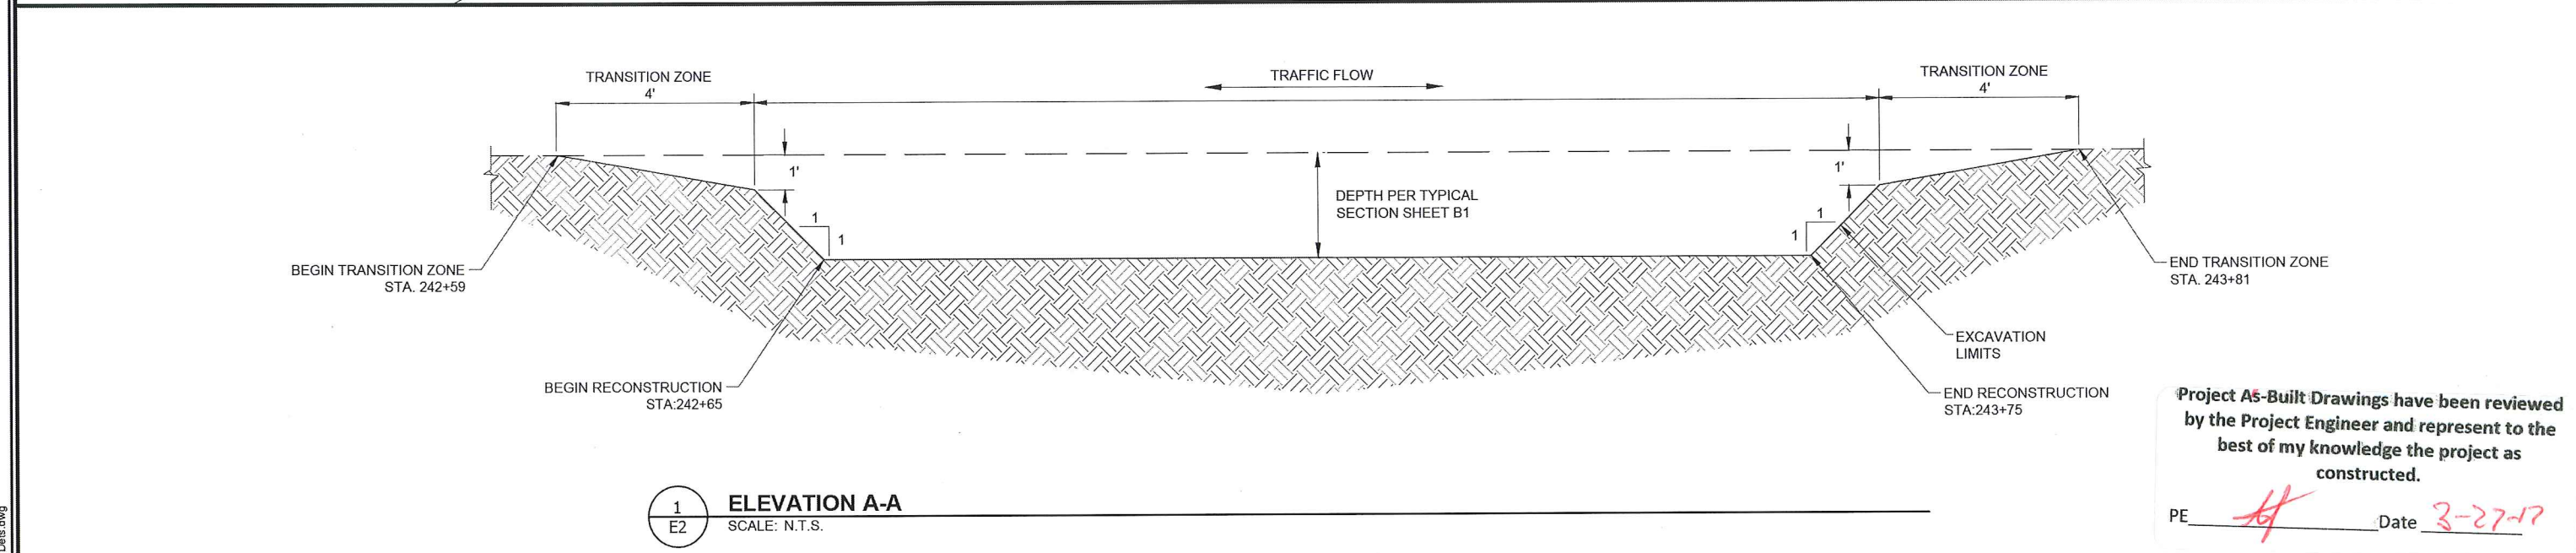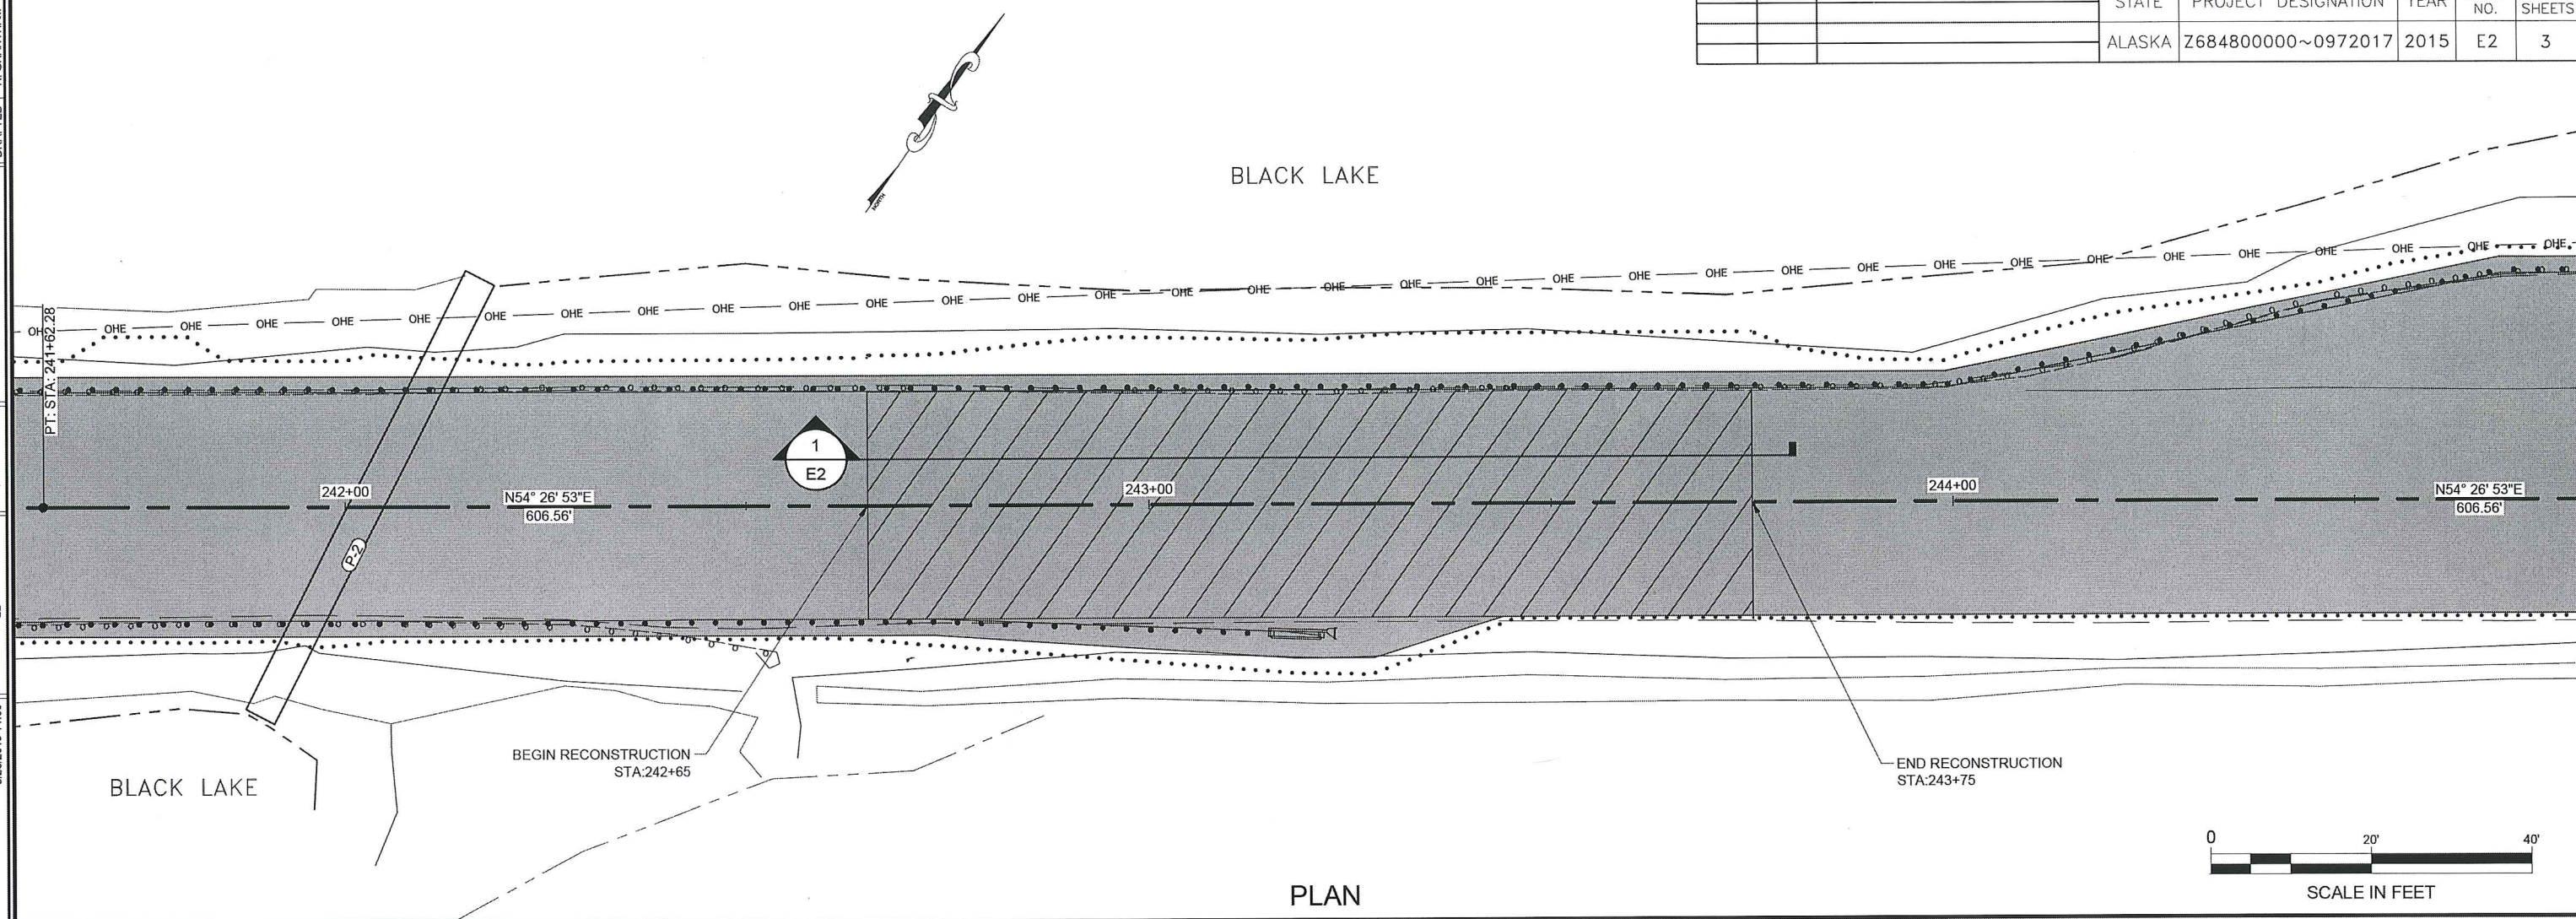

Project As-Built Drawings have been reviewed by the Project Engineer and represent to the best of my knowledge the project as constructed.

PE *[Signature]* Date *3-27-17*

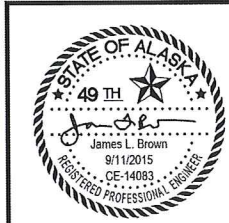

STATE OF ALASKA
DEPARTMENT OF TRANSPORTATION
AND PUBLIC FACILITIES

SGY: KLONDIKE HIGHWAY
REPAIRS

MISCELLANEOUS
DETAILS

DESIGNED: C. IVANISZEK
CHECKED: J. BROWN
DRAFTED: R. GRANTHAM

XREFS



SCALE

LAYOUT E3

DATE TIME 8/25/2015 11:50

DRAWING LOCATION Q:\Sgy\68480\Plan\68480_E2-E3_Misc.Dwg

NO.	DATE	REVISION	STATE	PROJECT DESIGNATION	YEAR	SHEET NO.	TOTAL SHEETS
			ALASKA	Z684800000~0972017	2015	E3	3

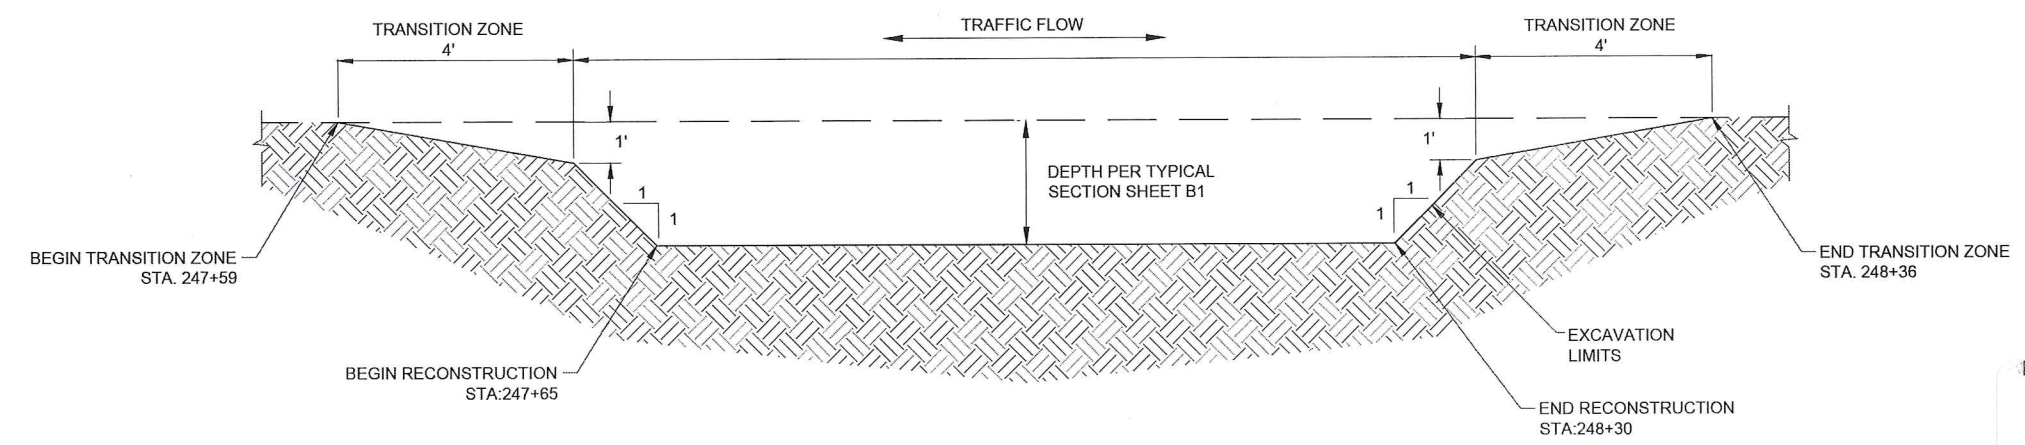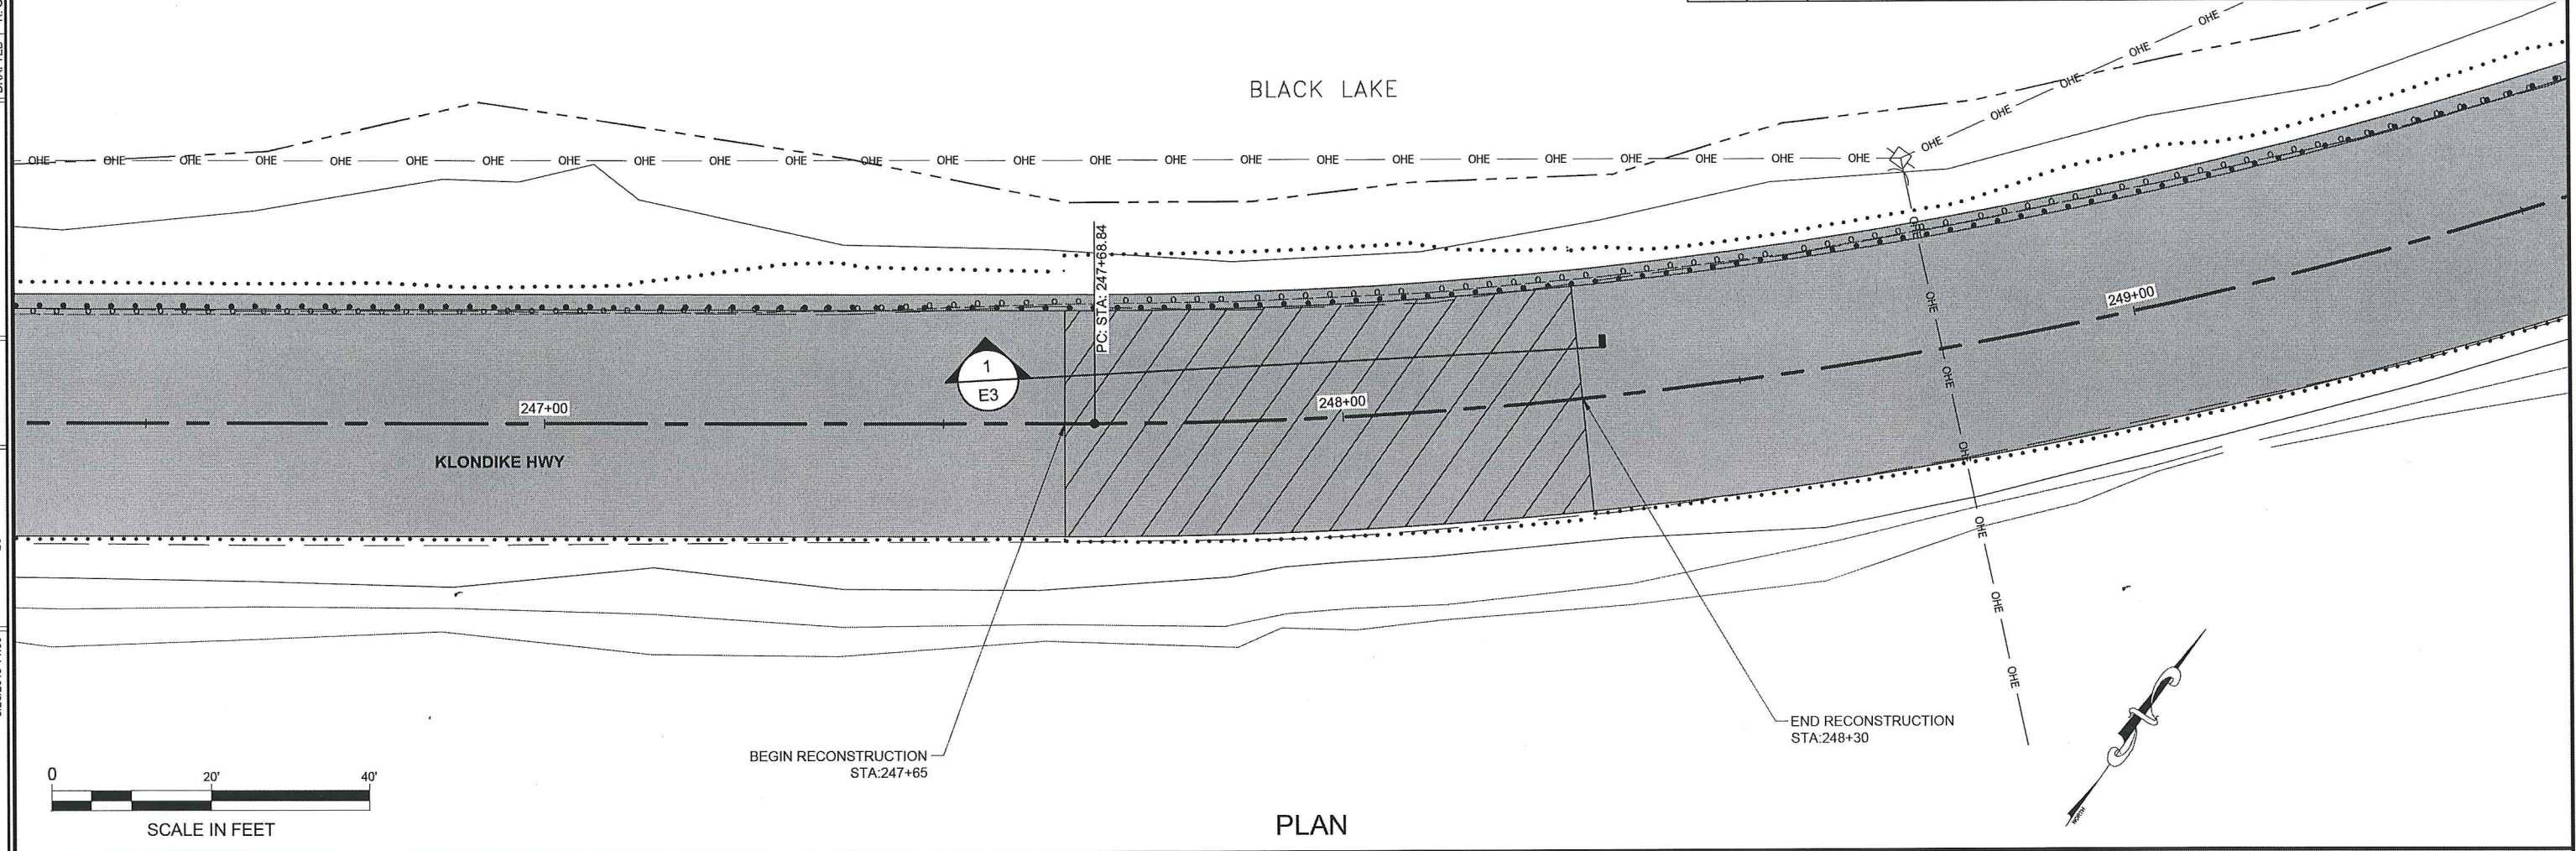

Project As-Built Drawings have been reviewed by the Project Engineer and represent to the best of my knowledge the project as constructed.

PE *[Signature]* Date 3-27-17





STATE OF ALASKA
DEPARTMENT OF TRANSPORTATION
AND PUBLIC FACILITIES

SGY: KLONDIKE HIGHWAY
REPAIRS

MISCELLANEOUS
DETAILS

DRAWING LOCATION		DATE	TIME	LAYOUT	SCALE	XREF'S	
I:\SocV\B4840\Plans\68480_F1-F6_P.P.dwg		8/28/2015	13:47	F2		DESIGNED	C. IVANISZEK
						CHECKED	J. BROWN
						DRAFTED	R. GRANTHAM

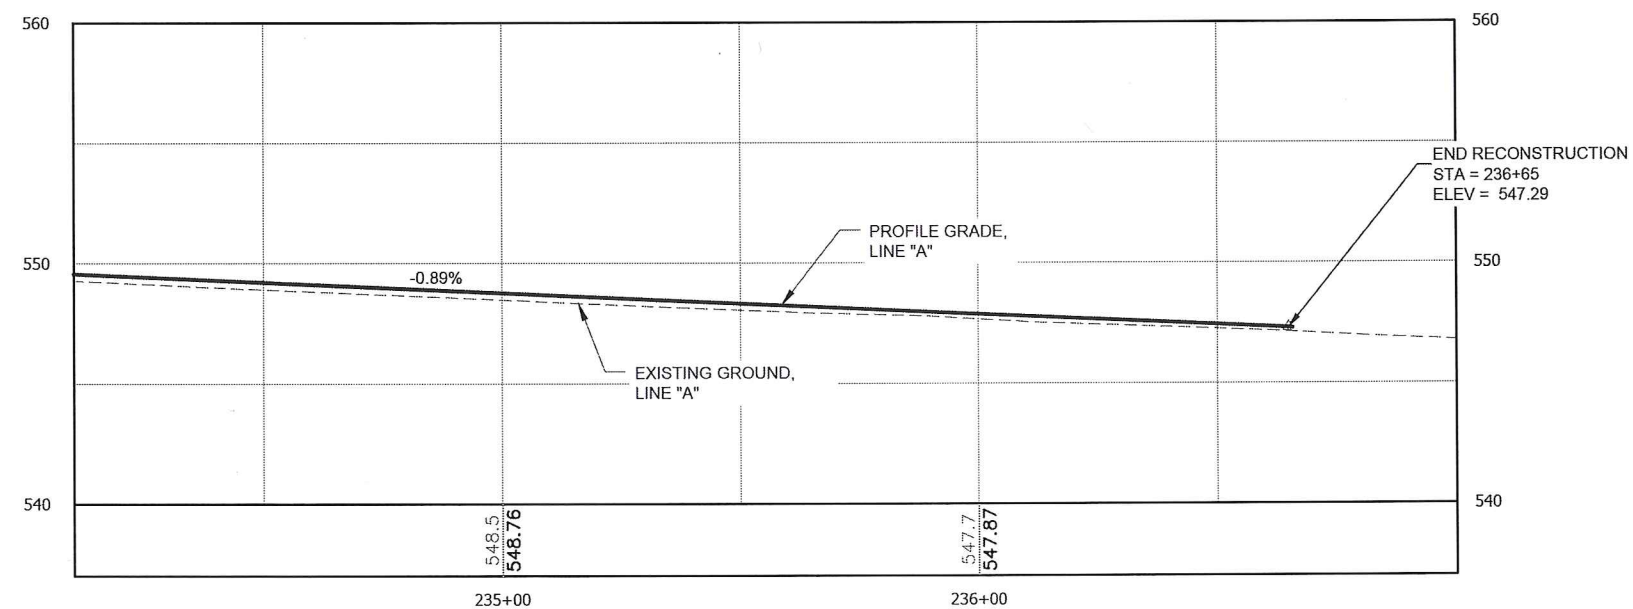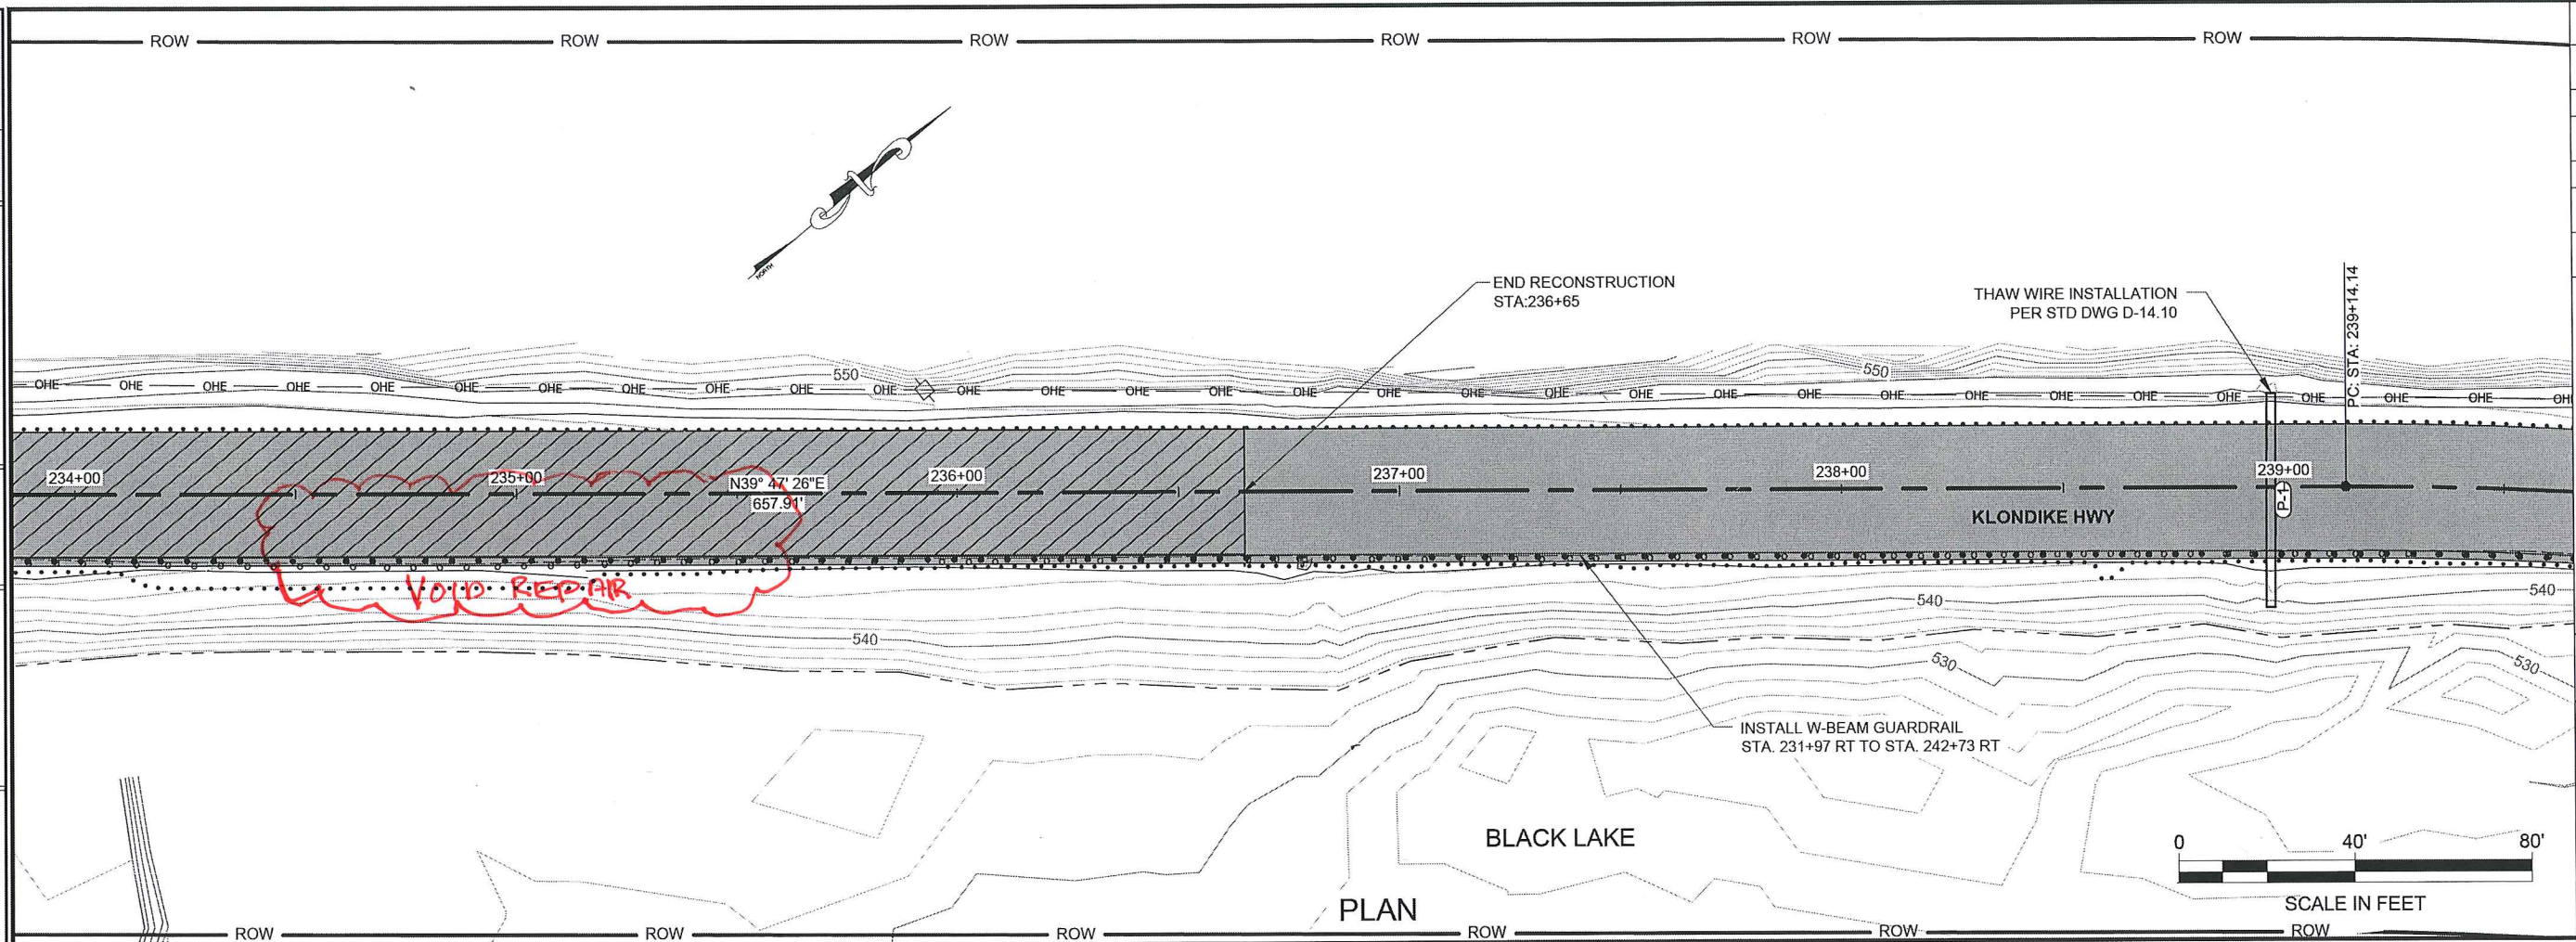

PROFILE

Project As-Built Drawings have been reviewed by the Project Engineer and represent to the best of my knowledge the project as constructed.

PE Date 3-27-17



STATE OF ALASKA
DEPARTMENT OF TRANSPORTATION
AND PUBLIC FACILITIES

SGY: KLONDIKE HWY
REPAIRS

PLAN & PROFILE

DESIGNED: C. IVANSZEK
CHECKED: J. BROWN
DRAFTED: R. GRANTHAM


XREFS

SCALE

LAYOUT
F4

DATE TIME
8/28/2015 13:47

DRAWING LOCATION
C:\Sg\68480\PlanSet\68480_F1-F6_P.P.dwg

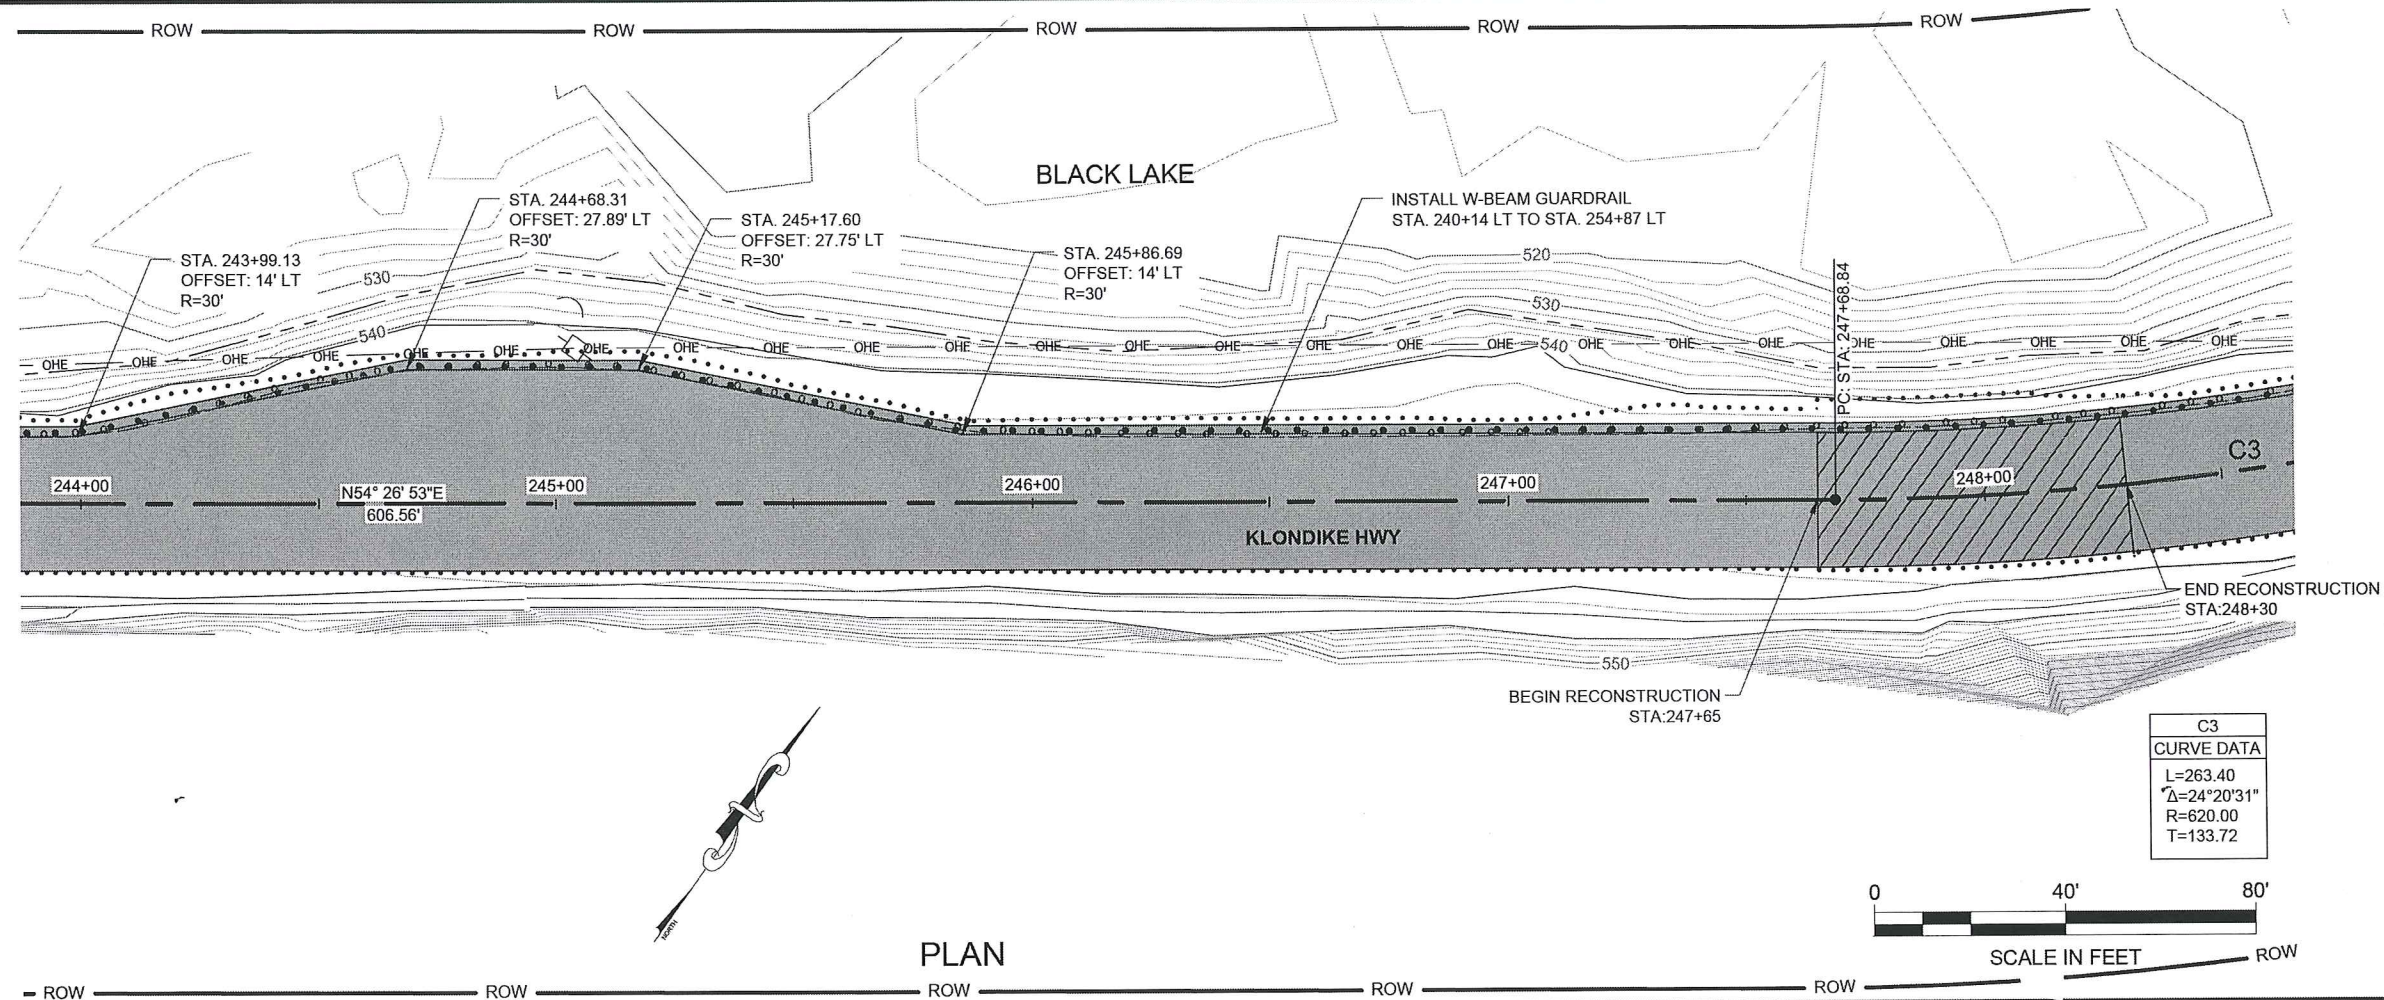

DESIGNED: C. IVANSZEK
CHECKED: J. BROWN
DRAFTED: R. GRANTHAM


XREFS

SCALE

LAYOUT P1

DATE TIME 8/25/2015 11:55

DRAWING LOCATION Q:\Spv\684801\PlanSet\68480_P1-P4_ESCP_P1n.dwg

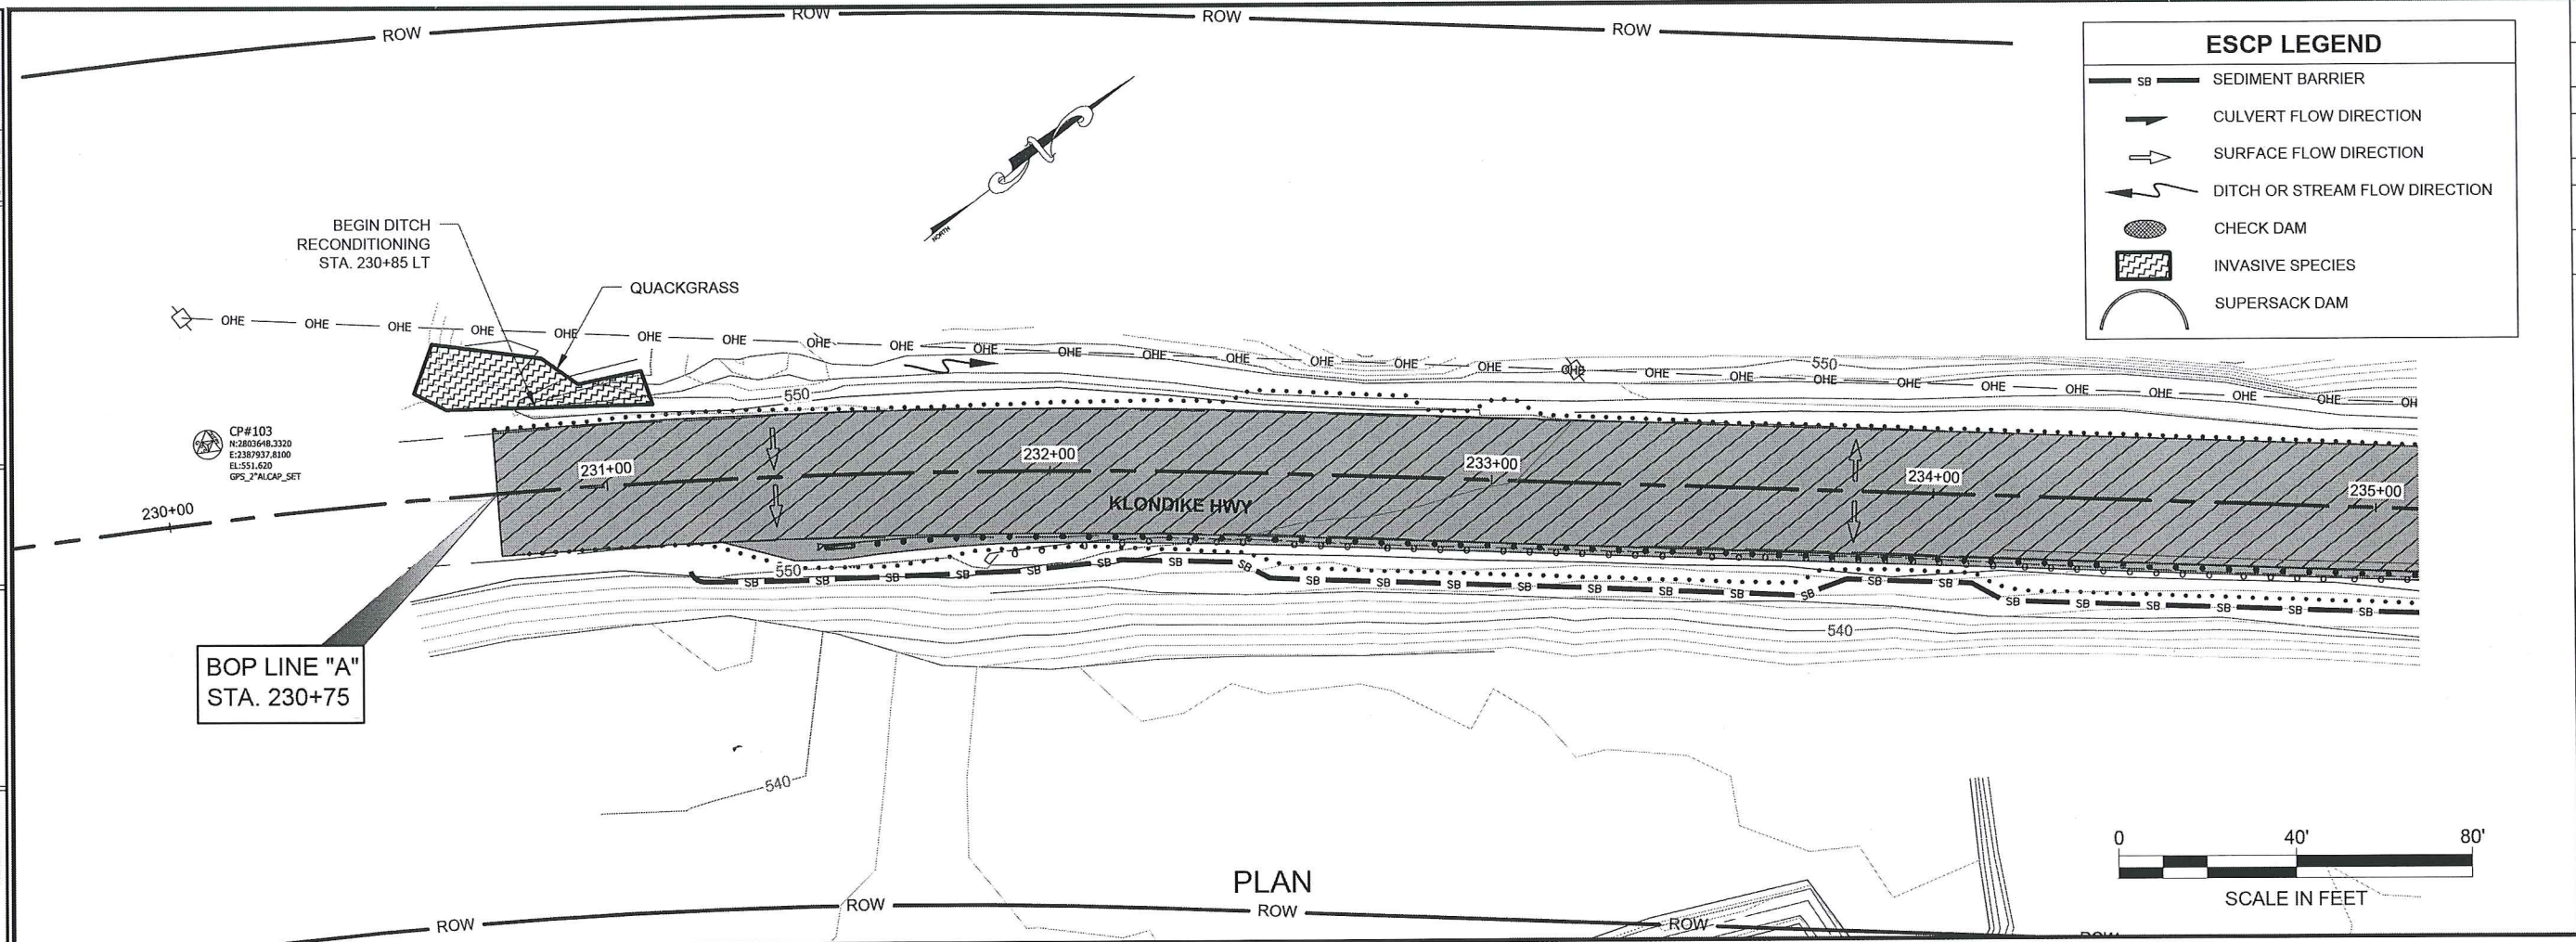


ESCP LEGEND

- SB SEDIMENT BARRIER
- CULVERT FLOW DIRECTION
- SURFACE FLOW DIRECTION
- DITCH OR STREAM FLOW DIRECTION
- CHECK DAM
- INVASIVE SPECIES
- SUPERSACK DAM

SHEET NO.	TOTAL SHEETS
P1	6
STATE	YEAR
ALASKA	2015
PROJECT DESIGNATION	
Z684800000~0972017	

REVISION	DATE	NO.

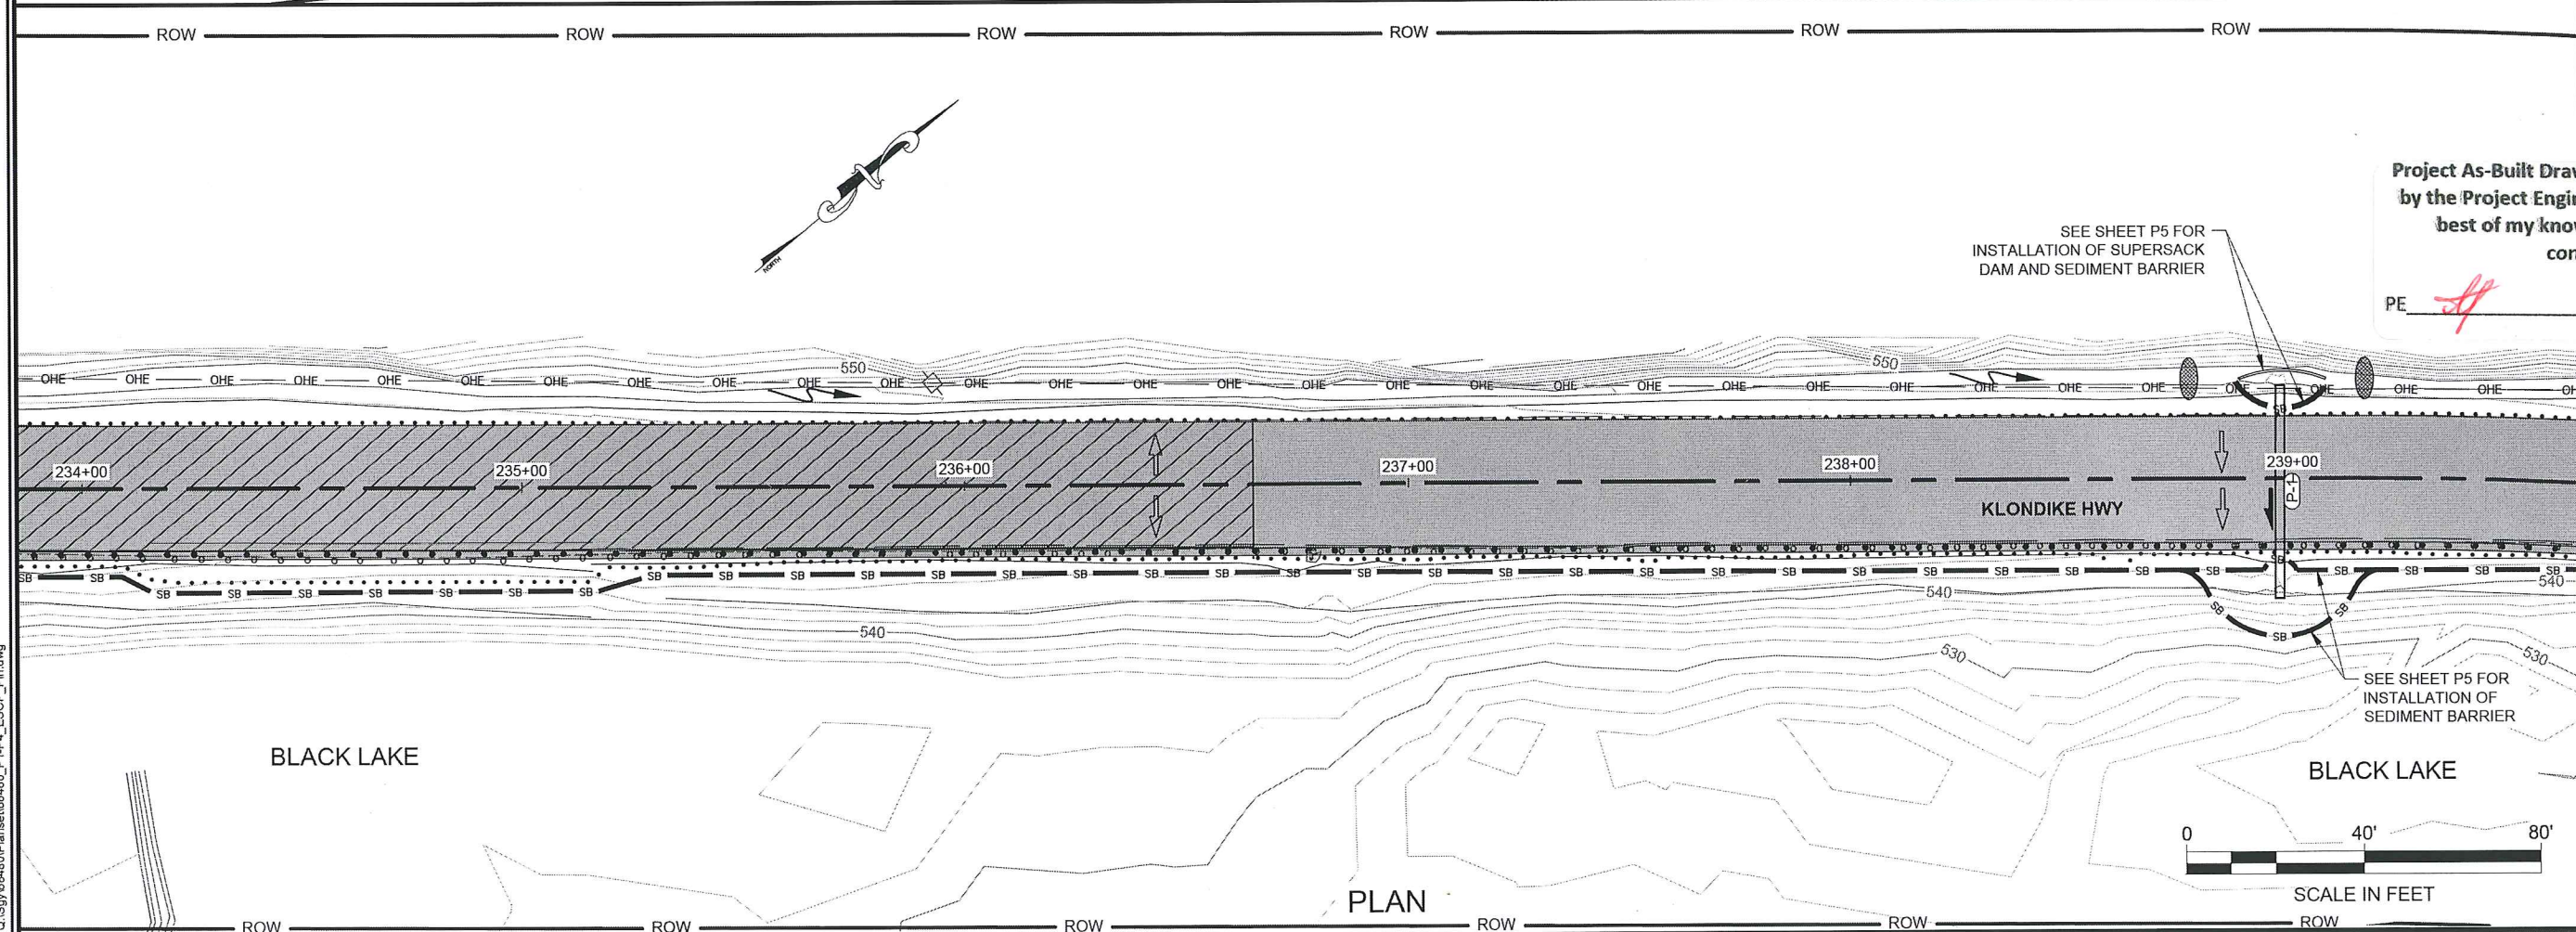

Project As-Built Drawings have been reviewed by the Project Engineer and represent to the best of my knowledge the project as constructed.

PE *[Signature]* Date 3-27-17

ESCP NOT SEALED
IN ACCORDANCE WITH ALASKA
HIGHWAY PRECONSTRUCTION
MANUAL
SECTION 1120.7.3
DATED NOVEMBER 15, 2013

STATE OF ALASKA
DEPARTMENT OF TRANSPORTATION
AND PUBLIC FACILITIES

SGY: KLONDIKE HWY
REPAIRS

EROSION & SEDIMENT
CONTROL PLAN

DESIGNED: C. MANISZEK
CHECKED: J. BROWN
DRAFTED: R. GRANTHAM



XREFS

SCALE

LAYOUT P2

DATE TIME 8/25/2015 11:55

DRAWING LOCATION Q:\Sg\68480\PlanSet\68480_P1-P4_ESCP_P1n.dwg

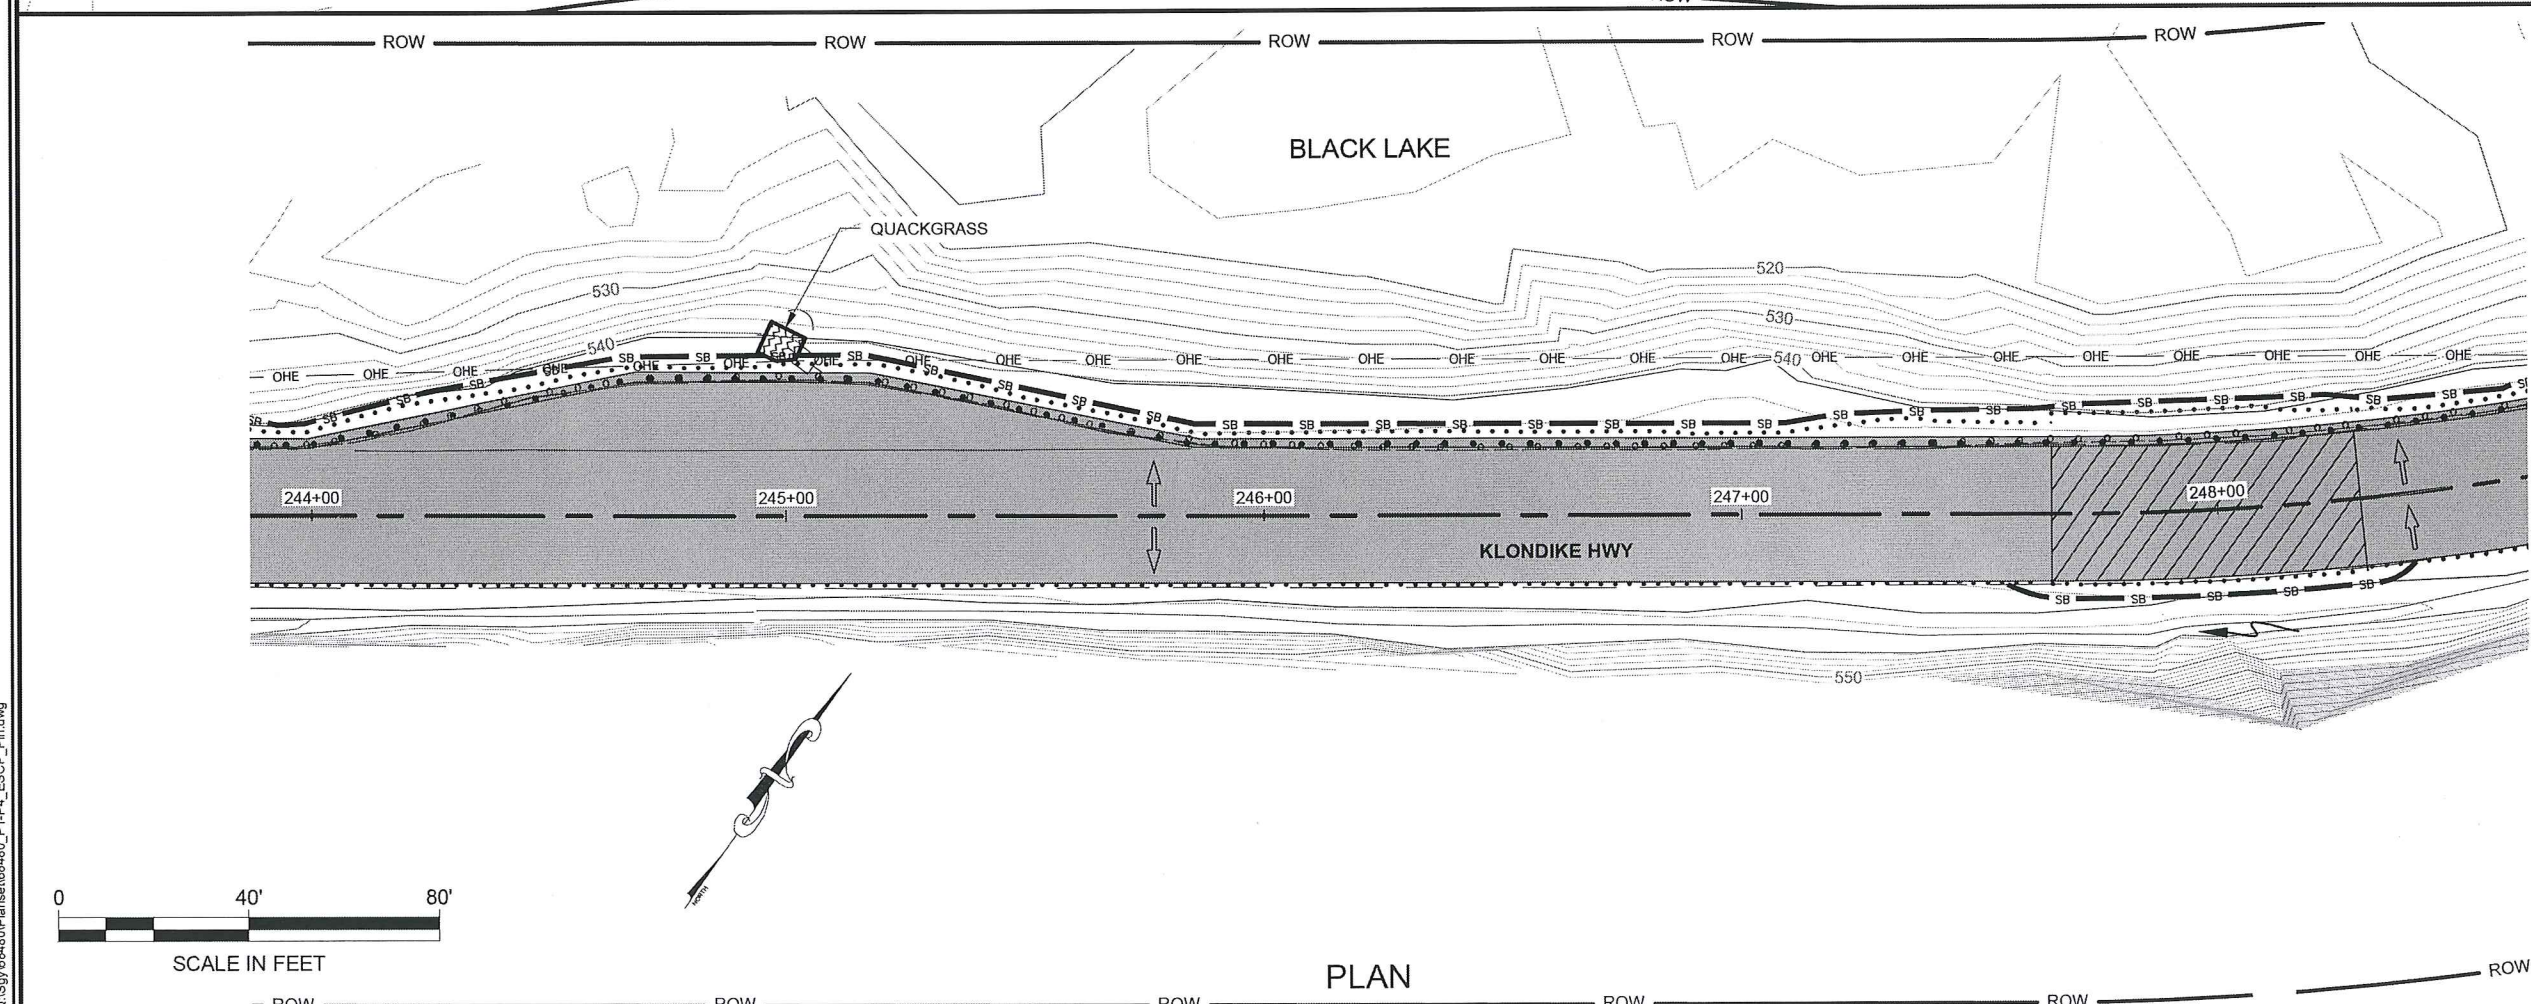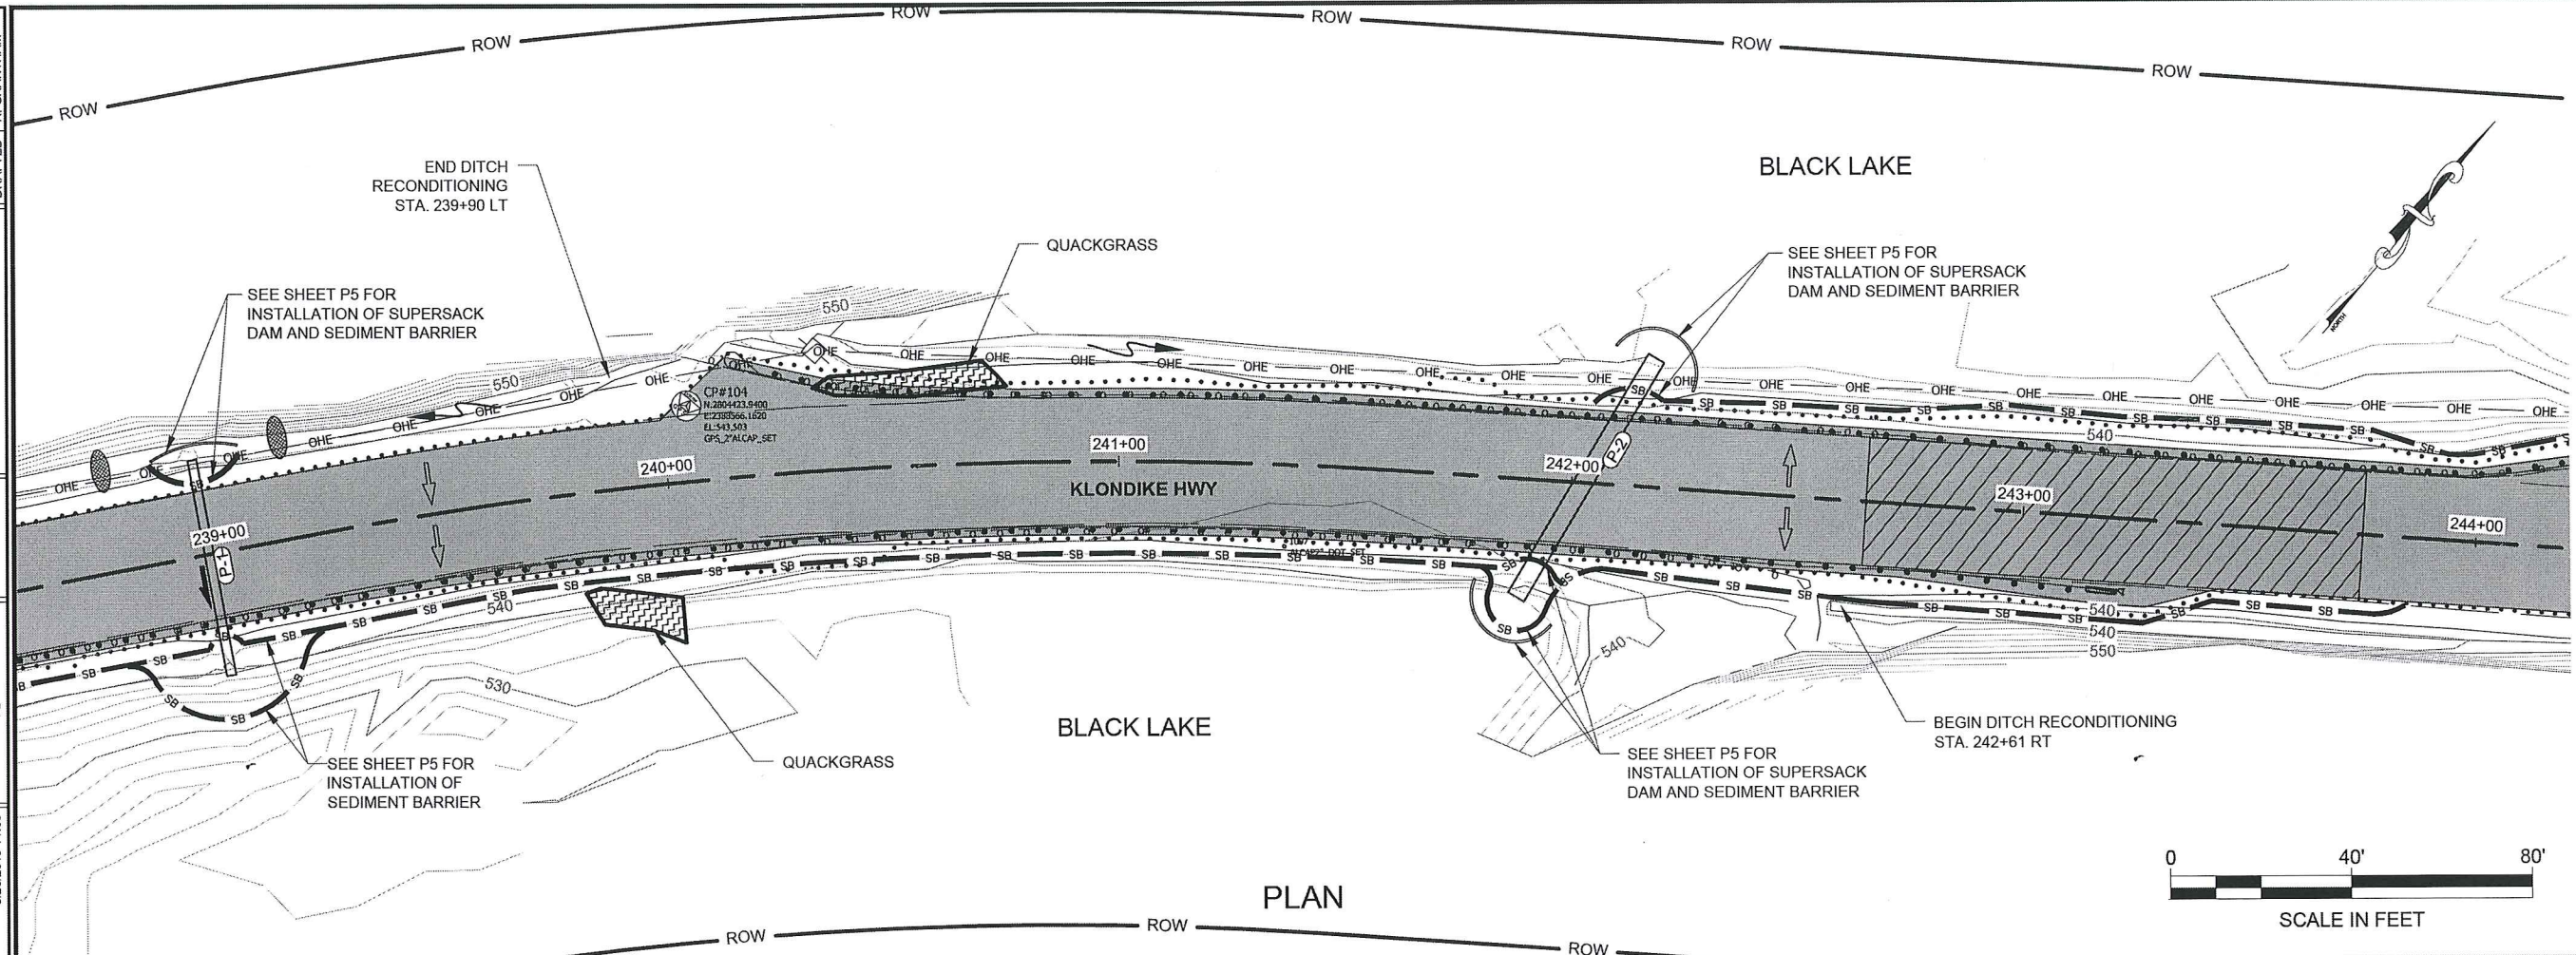

SHEET NO.	TOTAL SHEETS
P2	6
STATE	YEAR
ALASKA	2015
PROJECT DESIGNATION	
Z684800000~0972017	

REVISION	NO.	DATE

Project As-Built Drawings have been reviewed by the Project Engineer and represent to the best of my knowledge the project as constructed.

PE *[Signature]* Date 3-27-17

ESCP NOT SEALED
IN ACCORDANCE WITH ALASKA
HIGHWAY PRECONSTRUCTION
MANUAL
SECTION 1120.7.3
DATED NOVEMBER 15, 2013

STATE OF ALASKA
DEPARTMENT OF TRANSPORTATION
AND PUBLIC FACILITIES

SGY: KLONDIKE HWY
REPAIRS

EROSION & SEDIMENT
CONTROL PLAN

DESIGNED: C. IVANISZEK
CHECKED: J. BROWN
DRAFTED: R. GRANTHAM


XREFS

SCALE


LAYOUT P3

DATE TIME 8/25/2015 11:55

DRAWING LOCATION Q:\Sg\68480\PlanSet\68480_P1-P4_ESCP_P1n.dwg

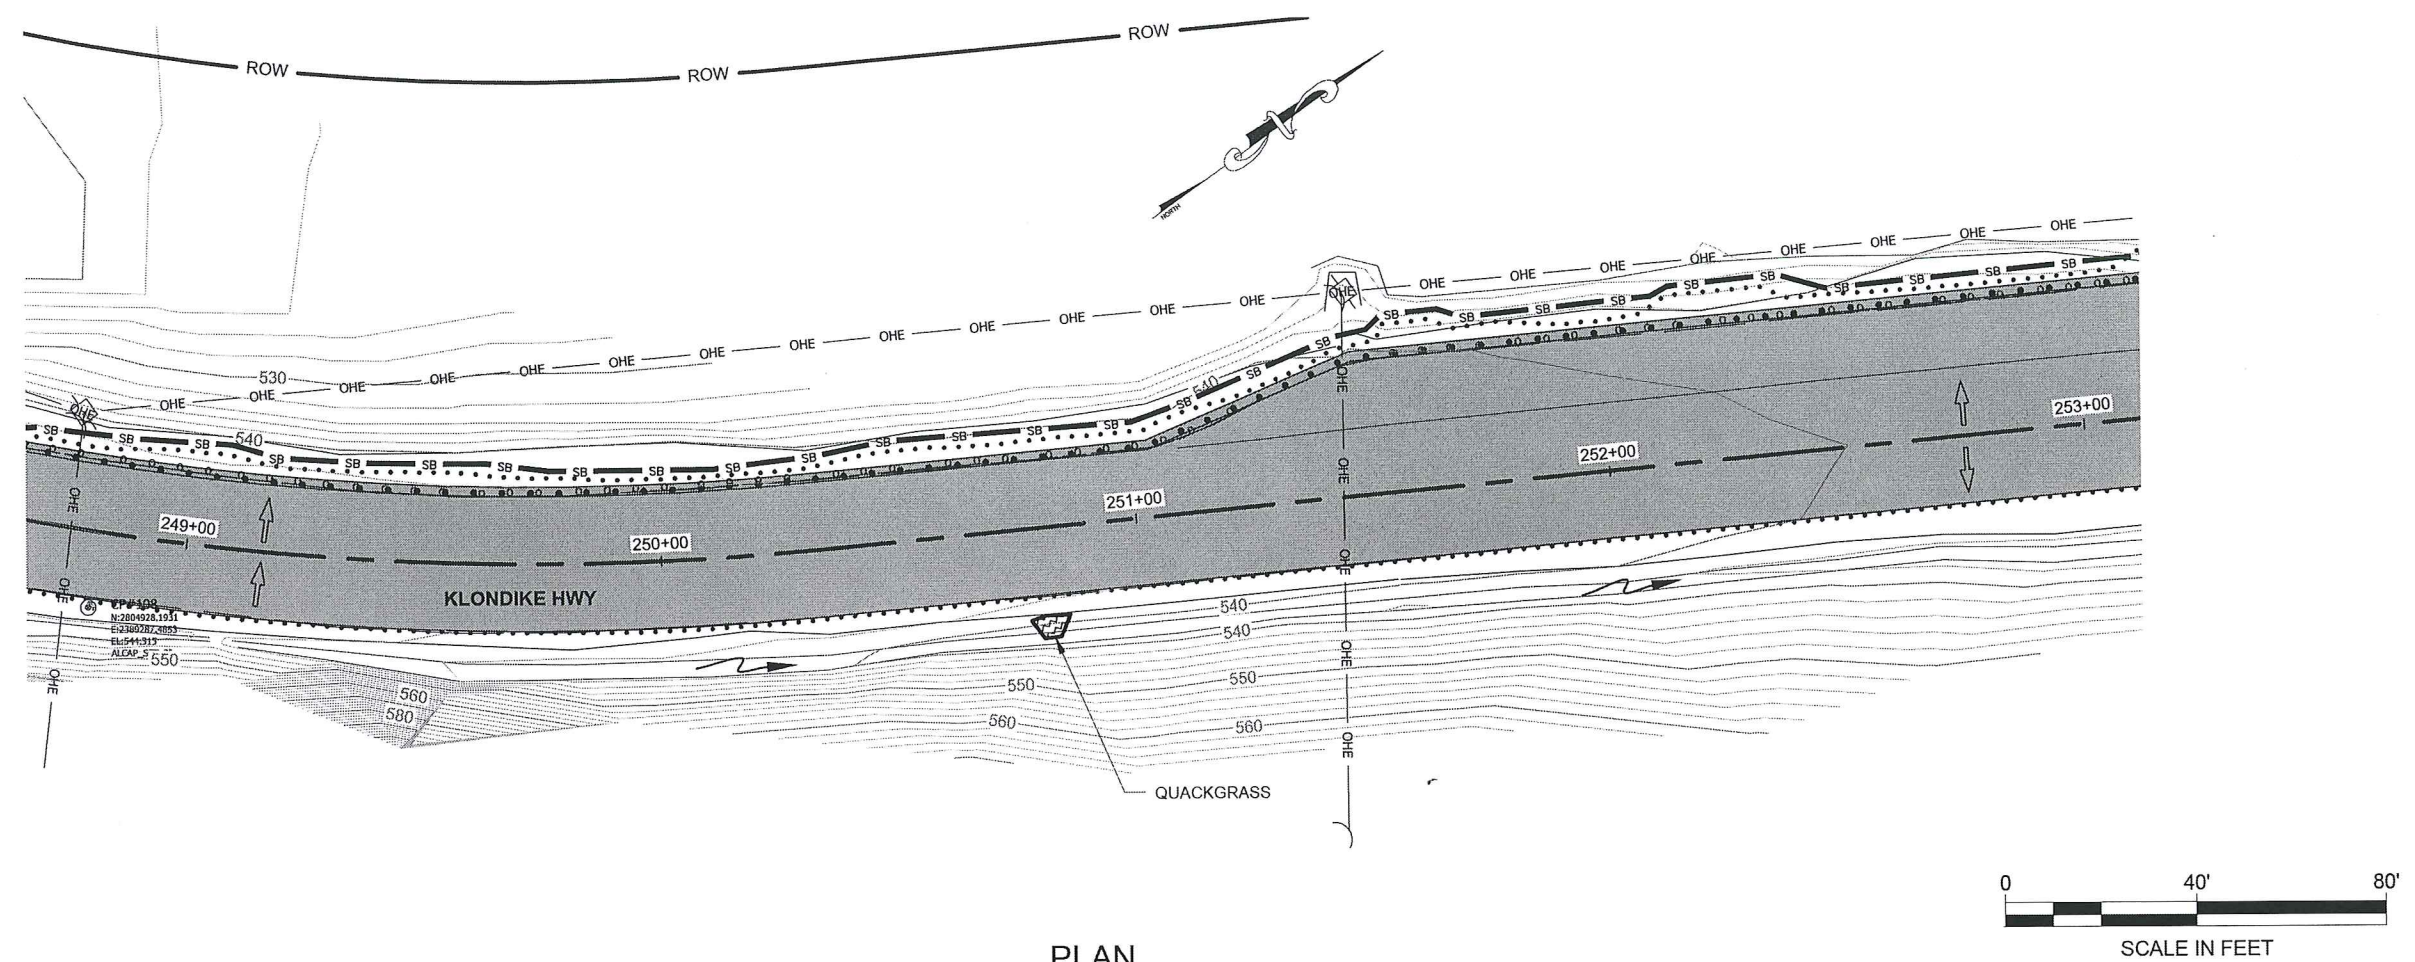

PLAN

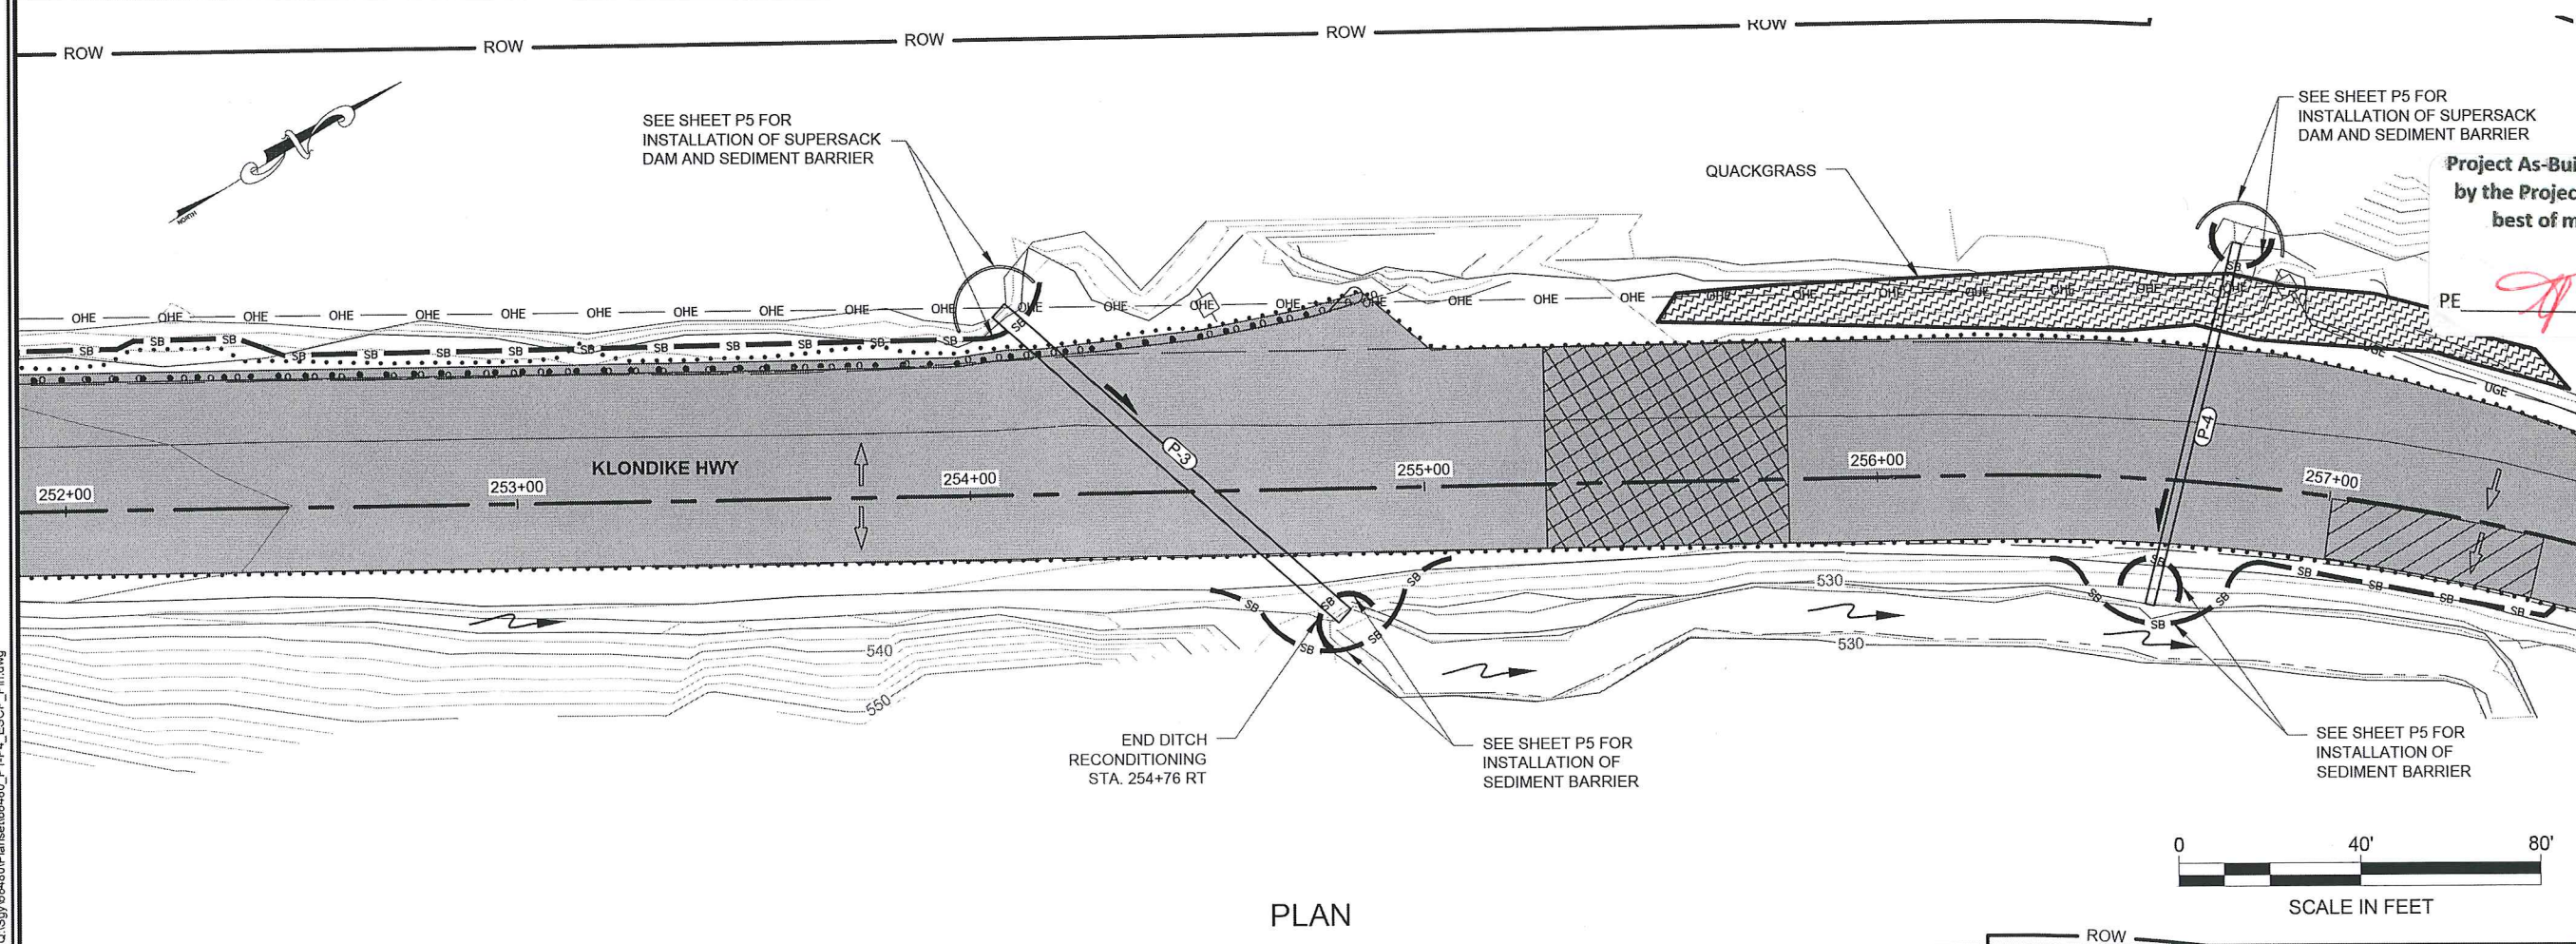

PLAN

SHEET NO.	TOTAL SHEETS
P3	6
STATE	YEAR
ALASKA	2015
PROJECT DESIGNATION	
Z684800000~0972017	

NO.	DATE	REVISION				

Project As-Built Drawings have been reviewed by the Project Engineer and represent to the best of my knowledge the project as constructed.

PE *[Signature]* Date **3-27-17**

ESCP NOT SEALED
IN ACCORDANCE WITH ALASKA
HIGHWAY PRECONSTRUCTION
MANUAL
SECTION 1120.7.3
DATED NOVEMBER 15, 2013

STATE OF ALASKA
DEPARTMENT OF TRANSPORTATION
AND PUBLIC FACILITIES

SGY: KLONDIKE HWY
REPAIRS

EROSION & SEDIMENT
CONTROL PLAN

DESIGNED: C. IVANSEK
CHECKED: J. BROWN
DRAFTED: R. GRANTHAM


XREFS

SCALE

LAYOUT P4

DATE TIME 8/25/2015 11:56

DRAWING LOCATION C:\Sgy\68480\PlanSet\68480_P1-P4_ESCP_Pln.dwg

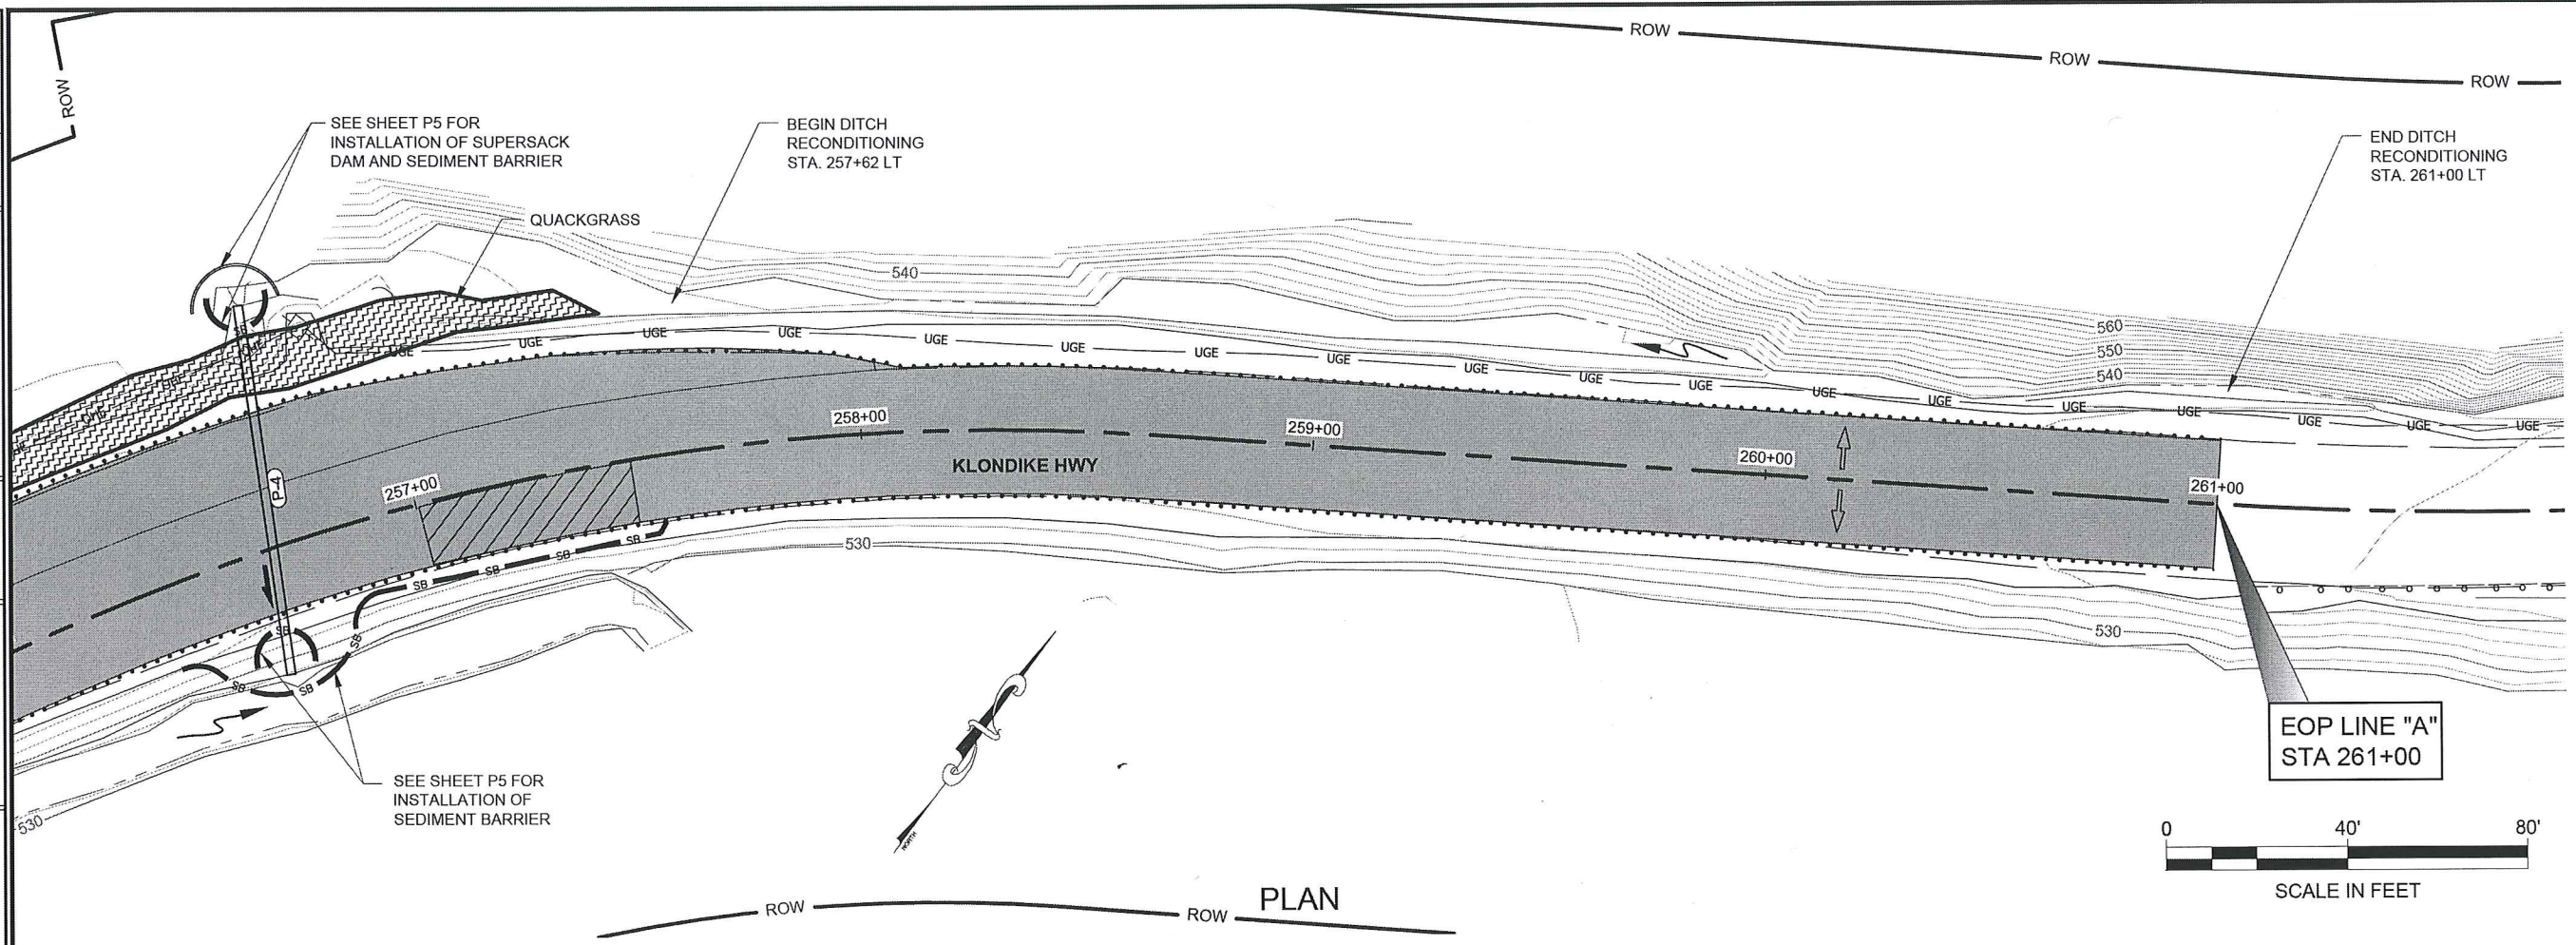

SHEET NO.	TOTAL SHEETS
P4	6
STATE	YEAR
ALASKA	2015
PROJECT DESIGNATION	
Z684800000~0972017	
REVISION	
DATE	
NO.	

Project As-Built Drawings have been reviewed
by the Project Engineer and represent to the
best of my knowledge the project as
constructed.

PE *[Signature]* Date *3-27-17*


ESCP NOT SEALED
IN ACCORDANCE WITH ALASKA
HIGHWAY PRECONSTRUCTION
MANUAL
SECTION 1120.7.3
DATED NOVEMBER 15, 2013

STATE OF ALASKA
DEPARTMENT OF TRANSPORTATION
AND PUBLIC FACILITIES

SGY: KLONDIKE HWY
REPAIRS

EROSION & SEDIMENT
CONTROL PLAN

NO.	DATE	REVISION	STATE	PROJECT DESIGNATION	YEAR	SHEET NO.	TOTAL SHEETS
			ALASKA	Z684800000~0972017	2015	P5	6

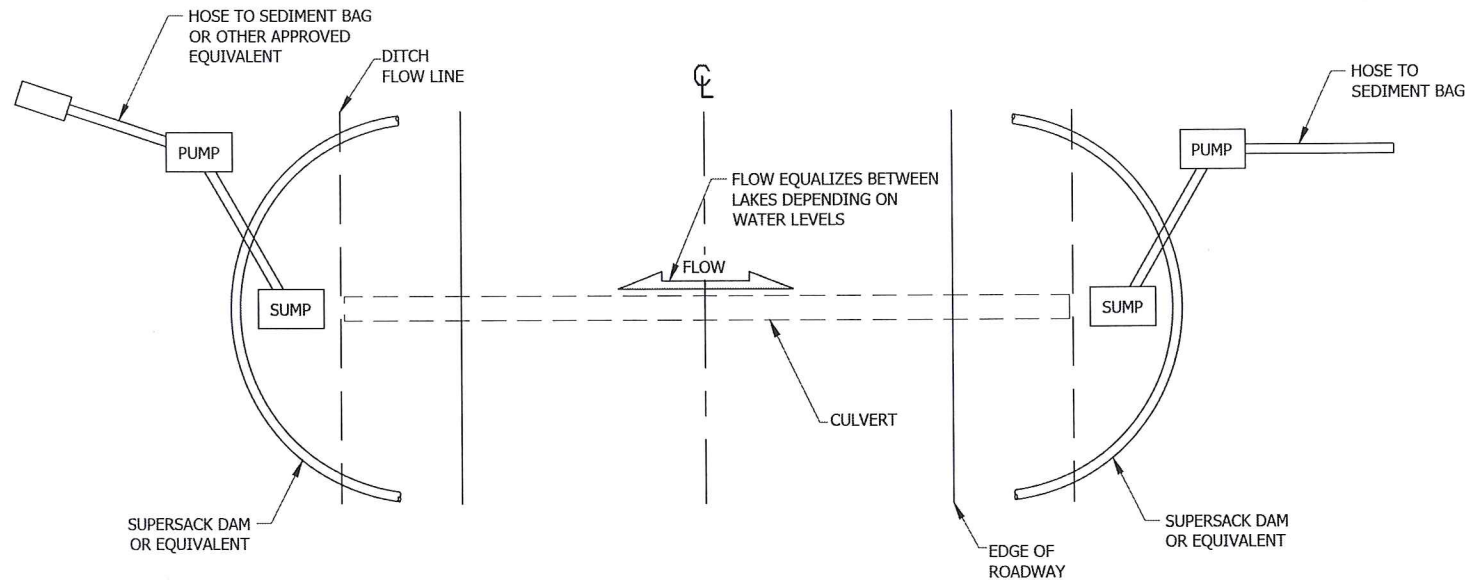


NOTE: DEWATER AND DISCHARGE MUST MEET WATER QUALITY STANDARDS.

SUPERSACK DAM PLACEMENT AT P-2

NTS

SEDIMENT BAG NOTES:

1. THE SEDIMENT BAG IS INTENDED TO CONTROL SEDIMENT DISCHARGE IN DEWATERING APPLICATIONS WHERE WATER IS BEING PUMPED.
2. REPLACE THE UNIT WHEN $\frac{1}{2}$ FULL OF SEDIMENT OR WHEN SEDIMENT HAS REDUCED THE FLOW RATE TO AN IMPRACTICAL RATE.

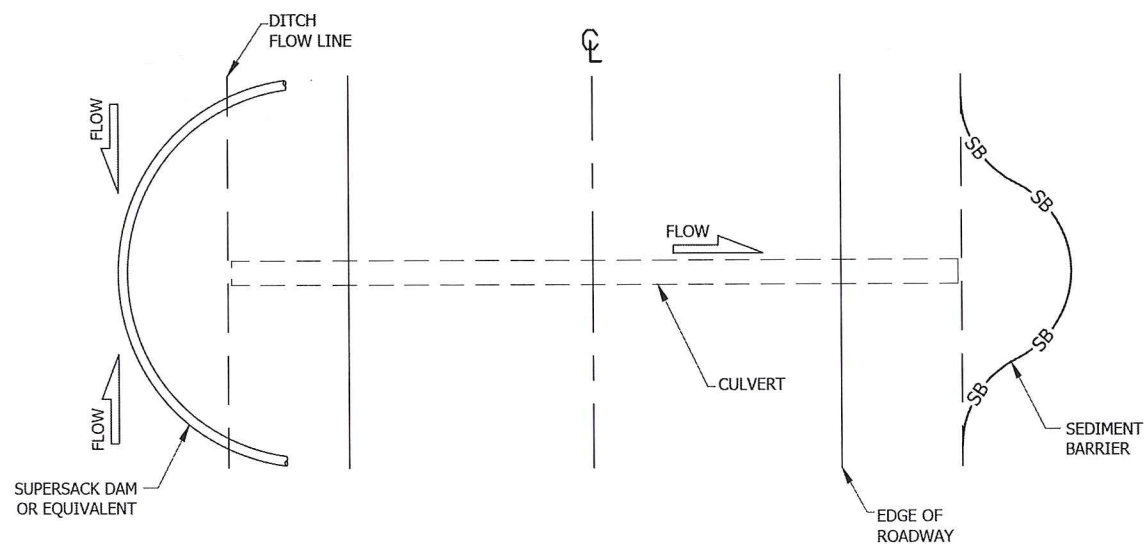


CULVERT REPLACEMENT DEWATERING AND BMP INSTALLATION

NTS

NOTES:

1. DIVERT OR DEWATER DRAINAGE FROM CULVERT INLET AS NECESSARY TO CONDUCT CULVERT REPLACEMENT ACTIVITIES.
2. ONCE FLOW HAS BEEN DIVERTED, INSTALL DOWN SLOPE SEDIMENT CONTROL TO MINIMIZE SEDIMENT DISCHARGE.
3. ONCE NEW CULVERT IS INSTALLED, REMOVE DOWN SLOPE SEDIMENT CONTROL BMP'S PRIOR TO REMOVING WATER DIVERSION/DEWATERING PUMP.

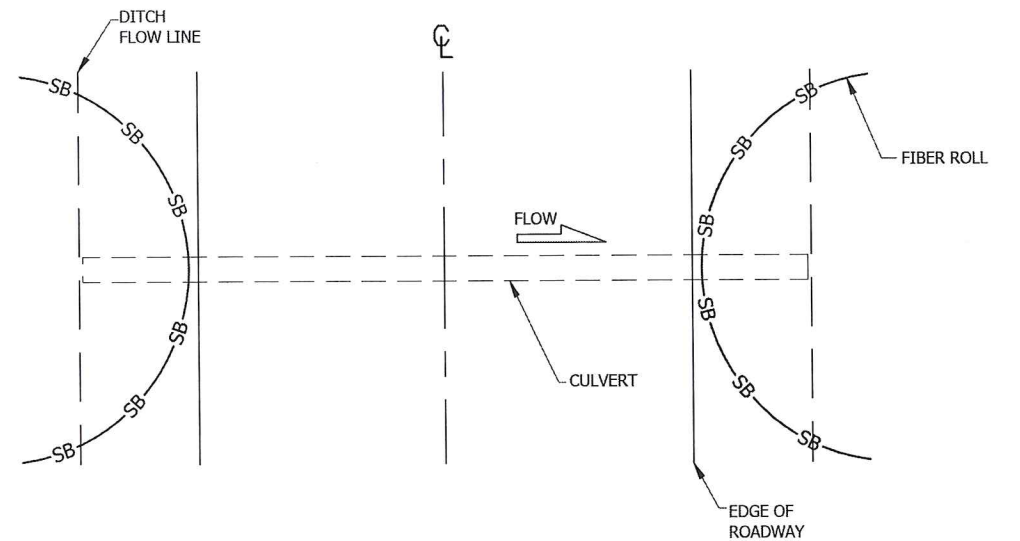

FIBER ROLL PLACEMENT AFTER CULVERT INSTALLATION

NTS

GENERAL NOTES:

1. CONTRACTOR IS RESPONSIBLE FOR THE INSTALLATION OF DOWNSLOPE PERIMETER CONTROL DURING CULVERT REPLACEMENT ACTIVITIES. PREPARE A WORK PLAN AND SUBMIT TO THE ENGINEER IN ACCORDANCE WITH SECTION 204-3.02.
2. REFER TO APPENDIX B OF THE SPECIAL PROVISIONS FOR THE ENVIRONMENTAL COMMITMENTS.
3. THE LOCATIONS OF TEMPORARY EROSION & SEDIMENT POLLUTION CONTROLS ARE RECOMMENDATIONS. IT IS THE RESPONSIBILITY OF THE CONTRACTOR TO PREPARE AND IMPLEMENT A WQCP ACCORDING TO SECTION 641 OF THE SPECS.
4. INSTALL EROSION AND SEDIMENT CONTROL DEVICES BEFORE BEGINNING ANY GROUND DISTURBING ACTIVITIES.

Project As-Built Drawings have been reviewed
by the Project Engineer and represent to the
best of my knowledge the project as
constructed.


PE  Date 3-27-17

ESCP NOT SEALED
IN ACCORDANCE WITH ALASKA
HIGHWAY PRECONSTRUCTION
MANUAL
SECTION 1120.7.3
DATED NOVEMBER 15, 2013


STATE OF ALASKA
DEPARTMENT OF TRANSPORTATION
AND PUBLIC FACILITIES

SGY: KLONDIKE HIGHWAY
REPAIRS

EROSION & SEDIMENT
CONTROL DETAILS

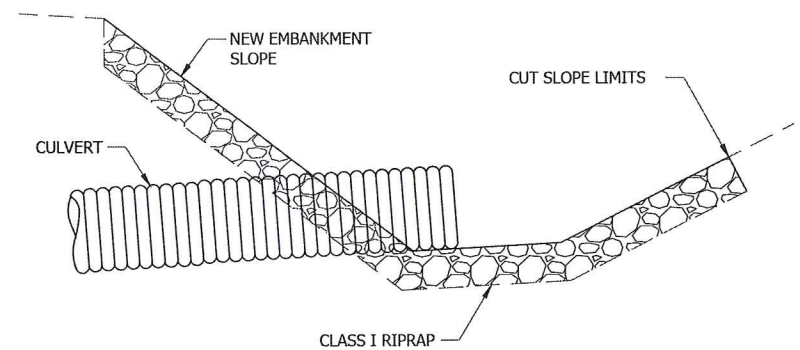


SECTION A2-A2
NTS

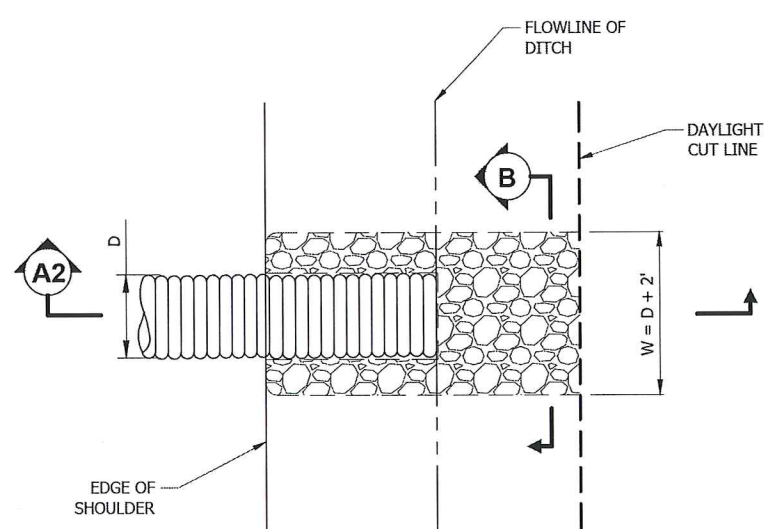


PLAN
NTS


RIPRAP LINED INLET PROTECTION DETAIL
NTS

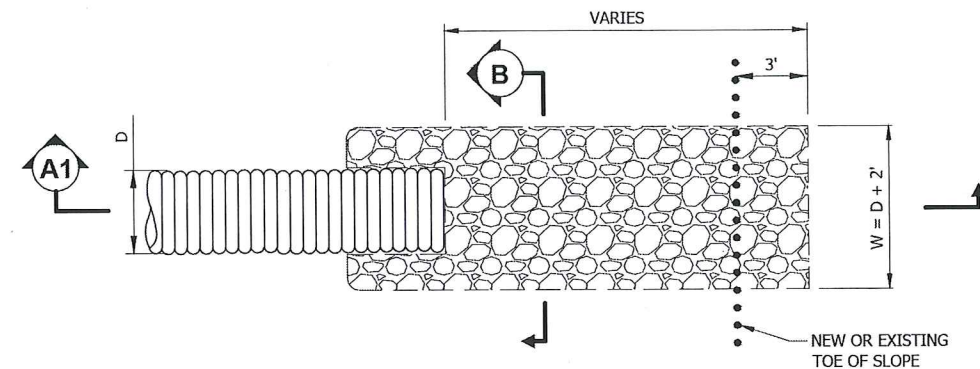

PLAN
NTS

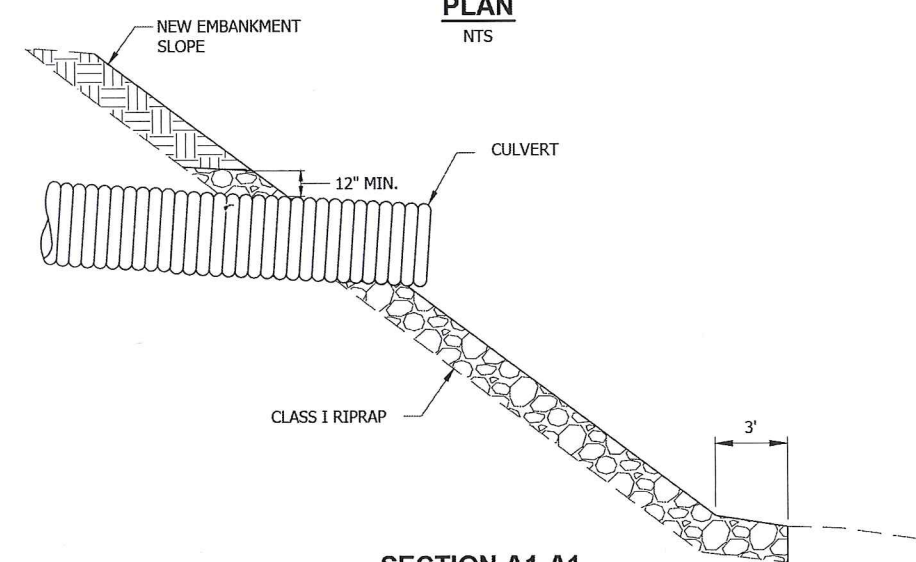


SECTION A1-A1
NTS

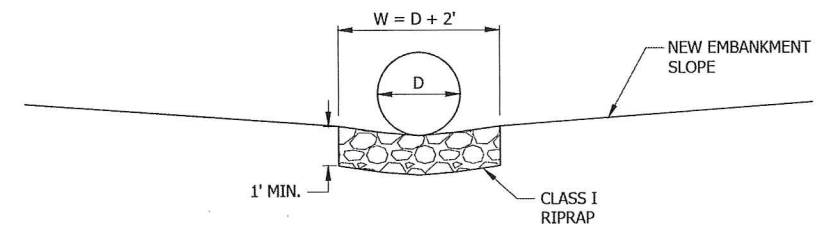

VIEW B-B
NTS

RIPRAP LINED OUTLET PROTECTION DETAIL
NTS

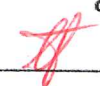Project As-Built Drawings have been reviewed
by the Project Engineer and represent to the
best of my knowledge the project as
constructed.
PE  Date 3-27-17

NO.	DATE	REVISION	STATE	PROJECT DESIGNATION	YEAR	SHEET NO.	TOTAL SHEETS
			ALASKA	Z684800000~0972017	2015	P6	6

DESIGNED: C. VANISZEK
CHECKED: D. ERSTEIN
DRAFTED: R. GRANTHAM

XREFS


SCALE

LAYOUT T1


DATE TIME 8/25/2015 12:01

DRAWING LOCATION Q:\Sgy\8480\Plans\8480_T1_Traf.dwg

NO.	DATE	REVISION	STATE	PROJECT DESIGNATION	YEAR	SHEET NO.	TOTAL SHEETS
			ALASKA	Z684800000~0972017	2015	T1	1

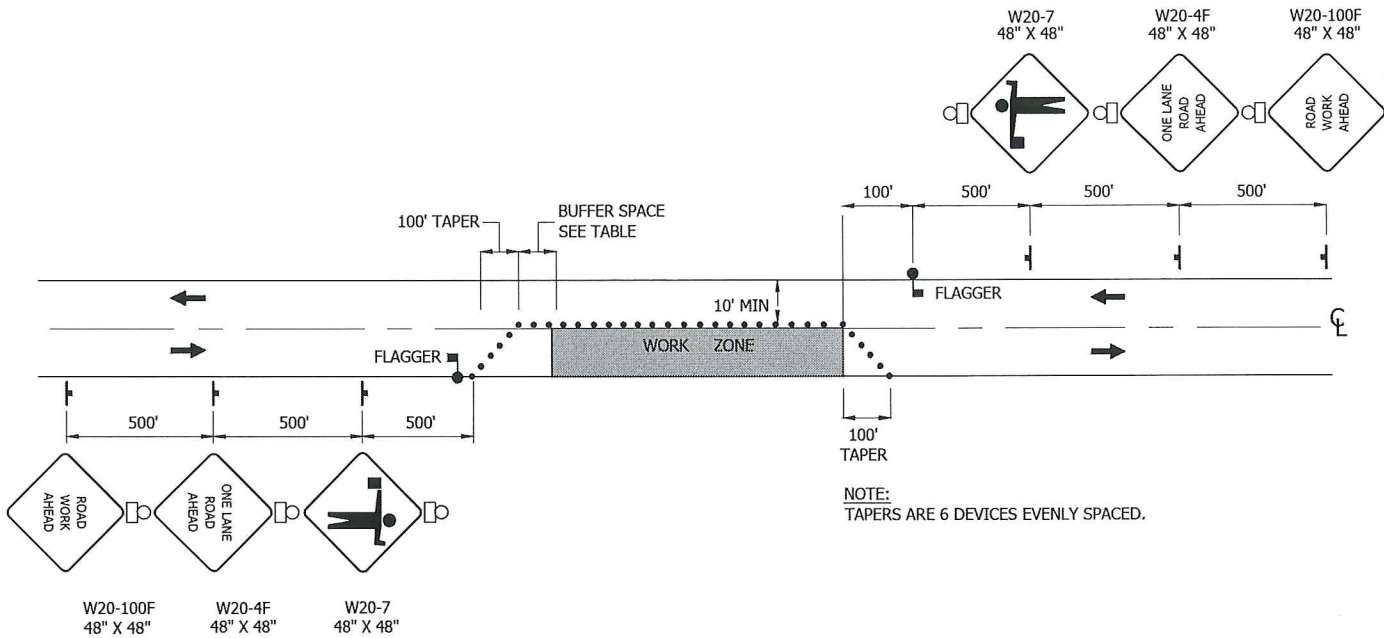


TWO LANE ROADWAY-SINGLE LANE CLOSURE

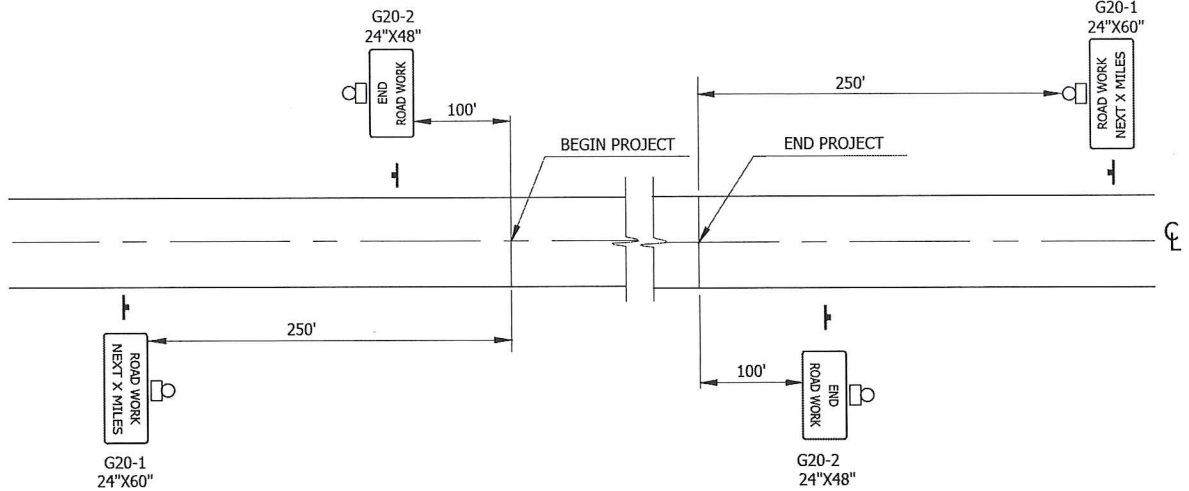

PERMANENT CONSTRUCTION SIGNING

NOTE: COORDINATE WITH AKDOT&PF PROJECT ENGINEER FOR PORTABLE MESSAGE BOARD.

NOTE:
IF ONLY ONE LANE IS EFFECTED BY ROAD WORK (THAT IS, THE CONES ALONG THE WORK AREA ARE NO CLOSER THAN 10' TO CENTERLINE) THE CENTERLINE CONES FOR THE OPPOSING LANE MAY BE DELETED. FOR DEVICE SPACING SEE TCP SETUP TABLE.

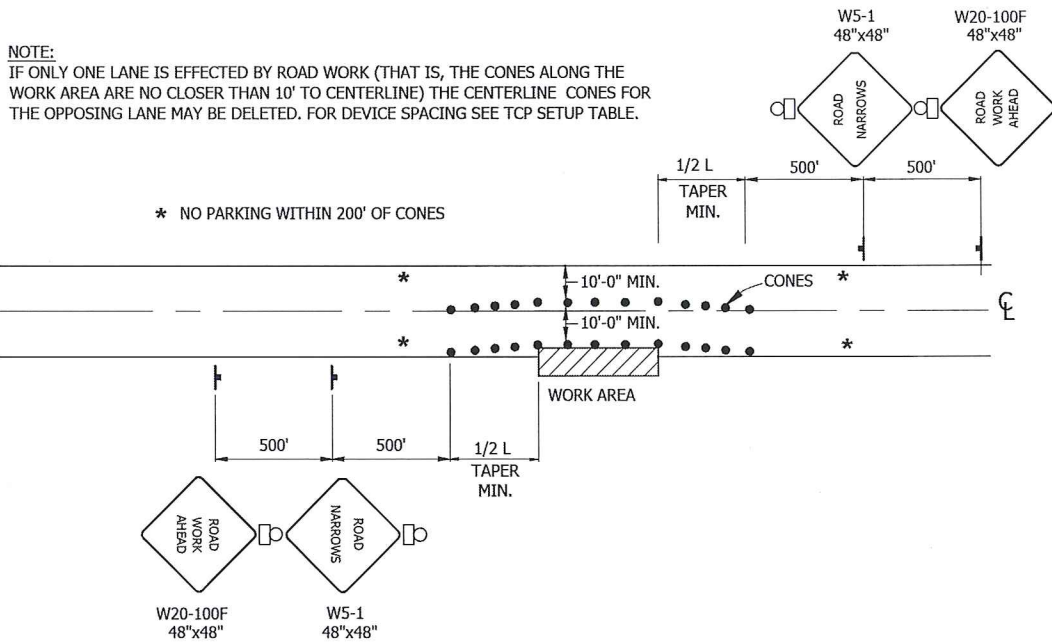

ROADWAY ENCROACHMENT


TRAFFIC CONTROL NOTES:

- DO NOT RESTRICT TRAFFIC FROM 8:00 AM TO 5:00 PM.
- ONE LANE OF TRAFFIC WILL REMAIN OPEN FROM 6:30AM TO 8:00 AM AND FROM 5:00 PM TO 11:30 PM.
- BOTH LANES OF TRAFFIC MAY BE CLOSED TO TRAFFIC FROM 11:30 PM TO 6:30 AM.
- TEMPORARY DRIVING LANES SHALL HAVE A MINIMUM WIDTH OF 10'-0".
- CONSTRUCTION SIGNING SHALL BE IN PLACE ONLY WHEN THE CONDITIONS EXIST FOR WHICH THE SIGNS ARE INTENDED.
- CHANNELIZATION DEVICES IF USED AT NIGHT SHALL BE LIT IN ACCORDANCE WITH THE ALASKA TRAFFIC MANUAL.
- IT IS THE INTENT OF THIS TRAFFIC CONTROL PLAN (TCP) TO ILLUSTRATE SOME, NOT ALL, OF THE TRAFFIC CONTROL SETUPS WHICH WILL BE REQUIRED ON THIS PROJECT. ALL THE TCP'S SHALL BE CREATED BY THE CONTRACTOR AND SUBMITTED TO THE ENGINEER FOR APPROVAL.
- ALL TRAFFIC CONTROL PLANS SUBMITTED BY THE CONTRACTOR SHALL BE NUMBERED. ALL TRAFFIC CONTROL PLANS THAT USE A TYPICAL APPLICATION AS DESCRIBED IN THE MUTCD SHALL REFERENCE THE TYPICAL APPLICATION. EXAMPLE: TCP 3, MUTCD TA-10.

LEGEND

- FLAGGER
- CONSTRUCTION SIGN
- DRUMS
- CONE
- WARNING LIGHT
- CRASH CUSHION
- BARRIER WALL

TCP SETUP TABLE									
SPEED (MPH)	MIN MERGING TAPER LENGTH (L) IN FEET			MIN NUMBER OF DEVICES WIDTH OF OFFSET (W) IN			MAX DEVICE SPACING IN FEET		BUFFER SPACE (FT)
	10'	11'	12'	10'	11'	12'	ALONG TAPER	ALONG TANGEN T	
35	205	225	245	7	8	8	35	70	250
40	270	295	320	8	9	9	40	80	305
45	450	495	540	11	12	13	45	90	360

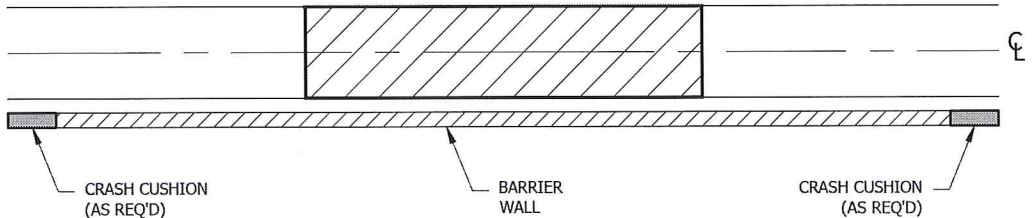

TEMPORARY BARRIER WALL PHASING PLAN

NOTES:

- REMOVE EXISTING GUARDRAIL.
- REPLACE GUARDRAIL WITH BARRIER WALL. PLACE CRASH CUSHIONS AT LOCATIONS THAT HAVE GUARDRAIL END TERMINALS.
- EXISTING PARALLEL GUARDRAIL TERMINALS ARE LOCATED AT STA. 231+85 RT & STA. 242+54 RT.
- CONTRACTOR IS TO HAVE ANY SECTIONS OF BARRIER WALL THAT ARE MOVED FOR ADJACENT LANE CONSTRUCTION IN PLACE BY 6:30 am OF THE FOLLOWING WORK DAY.

Project As-Built Drawings have been reviewed
by the Project Engineer and represent to the
best of my knowledge the project as
constructed.

PE *[Signature]* Date 3-27-17

TCP NOT SEALED
IN ACCORDANCE
WITH ALASKA HIGHWAY
PRECONSTRUCTION MANUAL
SECTION 1400.3.5
DATED JANUARY 30, 2012.


STATE OF ALASKA
DEPARTMENT OF TRANSPORTATION
AND PUBLIC FACILITIES

SGY: KLONDIKE HIGHWAY
REPAIRS


TRAFFIC CONTROL

GENERAL NOTES:

- 1. Final pavement markings conforming to Part 3 of the Alaska Traffic Manual should be installed before paved roads are open to public travel. If that is not practical, install interim pavement markings as shown on this drawing. Maintain interim pavement markings until final pavement markings are installed.
- 2. No interim pavement markings are required:
 - a. on projects that will not have permanent markings when finished.
 - b. in work zones that are open to public travel for no more than one work shift during daytime or for no more than one hour at night.
 - c. where DO NOT PASS and PASS WITH CARE signs are installed on two lane roads as shown in Detail C, no pavement markings are required:
 - 1) for 3 days if seasonal ADT is above 2000, or
 - 2) for 1 month if seasonal ADT is below 2000.
- 3. Interim pavement markings should not be in place longer than 14 calendar days before being replaced with permanent markings conforming to Part 3 of the Alaska Traffic Manual unless the Engineer provides written approval.
- 4. Where R4-1 DO NOT PASS signs are used, install at the beginning of no passing zones and at no more than 1500' spacings within no passing zones.
- 5. Install high level warning devices on all DO NOT PASS and PASS WITH CARE signs.
- 6. Offset temporary markings 8"-12" from the future location of permanent markings if applied on the same lift of pavement.
- 7. Dimensions in parenthesis apply to curves with a radius of 1000 feet or less or where posted speed limit is 30 mph or less.

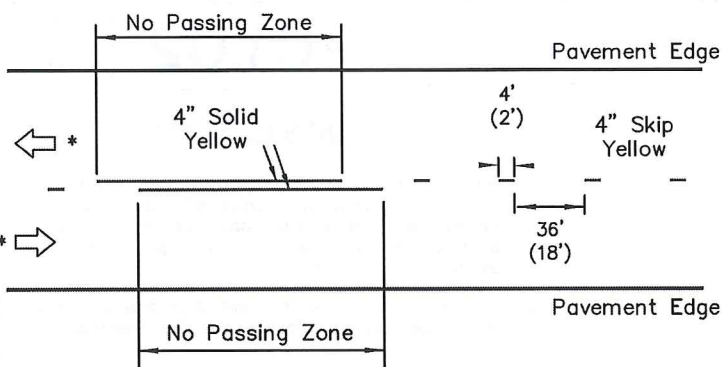


Striping

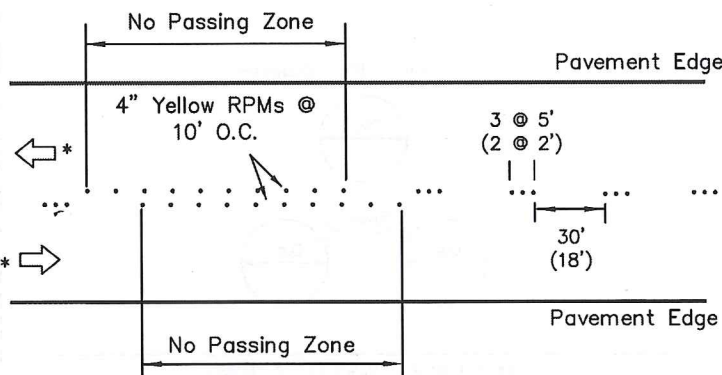

Temporary Raised Pavement Markers


DETAIL A

Two-lane road: No Passing Zones indicated with pavement markings.

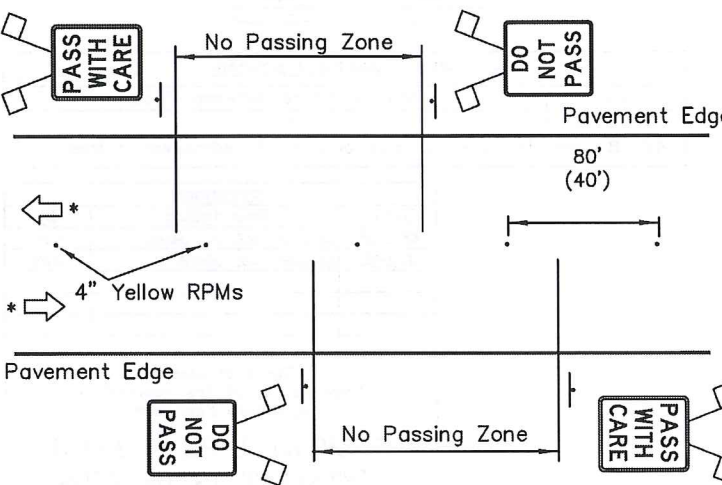


DETAIL B

Two-lane road: No Passing Zones indicated by signs only. Raised pavement markers for centerline delineation.

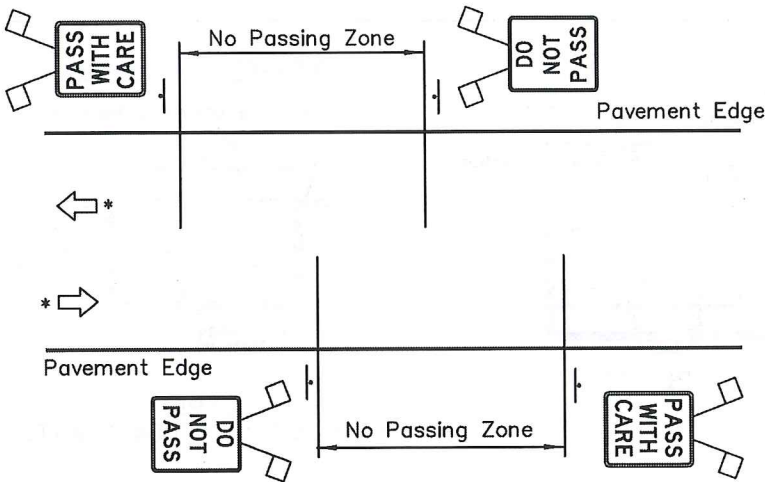


DETAIL C

Two-lane road: No Passing Zones indicated by signs only (see Note 2c). No centerline delineation.

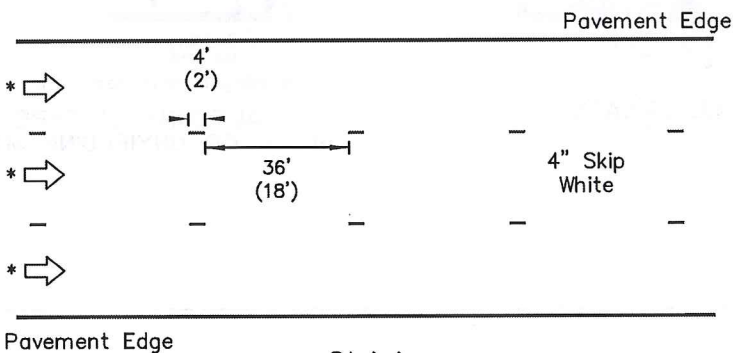

Striping

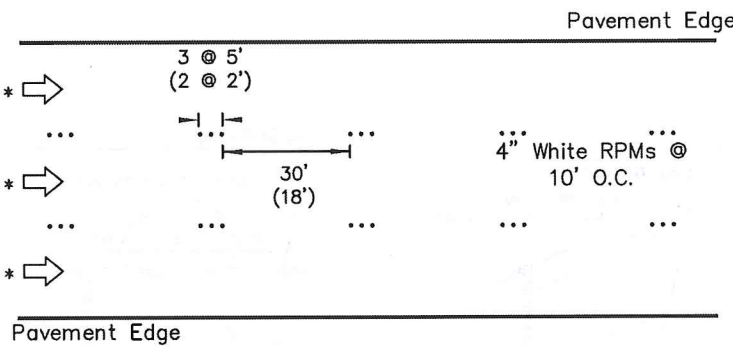

Temporary Raised Pavement Markers

DETAIL D

Multilane one-way road: Lane dividing lines

* Direction of Travel

REVISIONS		
Date	Description	By
4/28/10	RPM spacing, signs	KJS

Sheet 1 of 1

State of Alaska
Department of Transportation
& Public Facilities

INTERIM
PAVEMENT MARKINGS

APPROVED

49TH
Kurt A. Smith
CE-7347
4/28/10

Date 5/31/12

GENERAL NOTES:

- All material and workmanship shall be in accordance with the State of Alaska, Standard Specifications for Highway Construction.
- The contractor shall select only pipes that meet specific height of cover criteria shown on the plans or in the special provisions.
- No more than one type of pipe may be used on any single installation or installation grouping.
- All structural plate pipes shall be placed on a pre-shaped foundation conforming to the depth of the bottom plates with clearance for assembling to the adjacent plates allowed.
- See Standard Drawing "Culvert Pipe & Arch Installation Details" for foundation and structural backfill details.
- Minimum cover shall be measured from the top of pipe to the top of rigid pavement or to the top of flexible pavement subgrade. In all cases, the minimum cover shall not be less than 12". Minimum cover during construction shall be that required to protect the pipe from damage or deflection.
- These tables have been developed for an H-20 live load and for compacted soil weighing 120 lbs. per cubic foot or less. If compacted soil cover exceeds 120 lbs. per cubic foot, the contractor shall use the depth of cover shown in the plans for the specific pipe. Where compacted soil cover exceeds 120 lbs. per cubic foot and no specific cover requirements are provided in the plans, the contractor shall determine the required minimum pipe cover in accordance with Section 12 of the 2000 AASHTO "LRFD Bridge Design Specifications".

Minimum & Maximum Cover For 2 2/3" x 1/2" Aluminum Pipe										
GAGE	0.060"		0.075"		0.105"		0.135"		0.164"	
Dia. (in.)	Min. (in.)	Max. (ft)	Min. (in.)	Max. (ft)	Min. (in.)	Max. (ft)	Min. (in.)	Max. (ft)	Min. (in.)	Max. (ft)
12	12	100+	12	100+	12	100+	12	100+	12	100+
15	12	94	12	100+	12	100+	12	100+	12	100+
18	12	75	12	94	12	100+	12	100+	12	100+
21	12	65	12	82	12	100+	12	100+	12	100+
24	12	56	12	71	12	99	12	100+	12	100+
27	12	48	12	63	12	89	12	100+	12	100+
30			12	56	12	79	12	100+	12	100+
36			12	47	12	66	12	85	12	100+
42			12	55	12	56	12	73	12	100+
48			12	47	12	49	12	63	12	78
54					15	43	15	56	15	69
60							15	50	15	62
66							18	44	18	56
72									18	45

Minimum & Maximum Cover For 3" x 1" Aluminum Pipe										
GAGE	0.060"		0.075"		0.105"		0.135"		0.164"	
Dia. (in.)	Min. (in.)	Max. (ft)	Min. (in.)	Max. (ft)	Min. (in.)	Max. (ft)	Min. (in.)	Max. (ft)	Min. (in.)	Max. (ft)
30	12	52	12	65						
36	12	43	12	54	12	100+	12	100+	12	100+
42	12	36	12	46	12	65	12	100+	12	100+
48	12	32	12	40	12	57	12	73	12	100+
54	15	28	15	35	15	50	12	65	12	100+
60	15	25	15	32	15	45	15	58	15	72
66	18	23	18	28	18	41	18	53	18	65
72	18	21	18	26	18	37	18	48	18	59
78			21	24	21	34	21	44	21	55
84					21	31	21	41	21	57
90					24	29	24	38	24	47
96					24	27	24	36	24	44
102							24	33	24	41
108							24	31	24	39
114									24	37
120									24	35

Minimum & Maximum Cover For 9" x 2 1/2" Aluminum Structural Plate Pipe *																
GAGE	0.100"		0.125"		0.150"		0.175"		0.200"		0.225"		0.250"			
Dia. (in.)	Min. (in.)	Max. (ft)	Min. (in.)	Max. (ft)	Min. (in.)	Max. (ft)	Min. (in.)	Max. (ft)	Min. (in.)	Max. (ft)	Min. (in.)	Max. (ft)	Min. (in.)	Max. (ft)	Min. (in.)	Max. (ft)
60	12	29 31	12	38 45	12	49 60	12	58 70	12	68 81	12	78 92	12	88 100+	12	98 110+
66	12	26 28	12	35 41	12	44 54	12	53 64	12	63 74	12	73 84	12	83 94	12	93 105
72	13	24 25	12	32 37	12	41 50	12	48 58	12	56 67	12	64 77	12	72 86	12	80 96
78	14	22 23	12	29 35	12	37 46	12	45 54	12	53 62	12	61 71	12	69 79	12	77 89
84	15	20 22	13	27 32	12	35 42	12	41 50	12	48 58	12	56 66	12	64 74	12	72 84
90	16	19 20	14	25 30	13	32 40	12	39 47	12	46 54	12	54 64	12	62 72	12	70 82
96	17	18 19	15	24 28	14	30 37	13	36 44	12	43 50	12	50 60	12	58 68	12	66 78
102	18	17 18	16	22 26	15	29 35	14	34 41	13	40 47	13	47 57	13	55 65	13	63 75
108	19	16 17	17	21 25	16	27 33	14	32 39	14	38 45	14	45 55	14	53 63	14	61 73
114	20	15 16	18	20 23	16	25 31	15	30 37	15	36 42	15	42 52	15	50 60	15	58 70
120	21	14 15	19	19 22	17	24 30	16	29 35	15	34 40	15	40 50	15	48 58	15	56 68
126	22	13 14	20	18 21	18	23 28	17	27 33	16	32 38	16	38 48	16	46 56	16	54 66
132	23	13 14	21	17 20	19	22 27	18	26 32	17	31 37	17	37 47	17	45 55	17	53 65
138	24	12 13	22	16 19	20	21 26	18	25 30	18	30 36	18	36 46	18	44 54	18	52 64
144	25	12 12	22	16 18	21	20 25	19	24 29	18	29 33	18	34 44	18	42 52	18	50 62
150			23	15 18	21	19 24	20	23 28	19	27 32	19	32 42	19	40 50	19	48 60
156			24	14 17	22	18 23	21	22 27	20	26 31	20	31 41	20	39 49	20	47 59
162					23	18 22	21	21 26	21	25 30	21	30 40	21	38 48	21	46 58
168					24	17 21	22	20 25	21	24 29	21	29 39	21	37 47	21	45 57
174					25	17 20	23	20 24	22	24 28	22	29 39	22	37 47	22	45 57
180							24	19 23	23	23 27	23	28 38	23	36 46	23	44 56

*Longitudinal seams use (5 1/3)
3/4" dia. bolts per foot.

58
100+

Upper figure for pipe with aluminum bolts.

(FOR TABLE ABOVE ONLY.)

Lower figure for pipe with galvanized steel bolts.

CORRUGATED CIRCULAR ALUMINUM PIPE

CORRUGATED ALUMINUM PIPE-ARCH

Minimum & Maximum Cover For 2 2/3" x 1/2" Aluminum Pipe-Arch						
				Max. Cover (ft)		
Span x Rise (in. x in.)	Corner Radius (in.)	Minimum Gage (in.)	Min. Cover (in.)	2 Tons Corner Bearing Pressure	3 Tons Corner Bearing Pressure	@
17 x 13	3	0.060	12	13	20	
21 x 15	3	0.060	12	12	19	
24 x 18	3	0.060	12	11	16	
28 x 20	3	0.075	12	10	16	
35 x 24	3	0.075	12	9	14	
42 x 29	3 1/2	0.105	12	7	13	
49 x 33	4	0.105	15	6	12	
57 x 38	5	0.135	15	6	12	
64 x 43	6	0.135	18	6	12	
71 x 47	7	0.164	18	6	12	

Minimum & Maximum Cover For 3" x 1" Aluminum Pipe-Arch						
				Max. Cover (ft)		
Span x Rise (in. x in.)	Corner Radius (in.)	Minimum Gage (in.)	Min. Cover (in.)	2 Tons Corner Bearing Pressure	3 Tons Corner Bearing Pressure	@
40 x 31	5	0.075	30	8	12	
46 x 36	6	0.075	24	8	13	
53 x 41	7	0.075	24	8	13	
60 x 46	8	0.075	24	13	20	
66 x 51	9	0.075	18	13	20	
73 x 55	12	0.075	18	16	24	
81 x 59	14	0.105	18	14	22	
87 x 63	14	0.105	18	13	20	
95 x 67	16	0.105	18	12	18	
103 x 71	16	0.135	24	11	17	
112 x 75	18	0.164	24	10	16	
117 x 79	18	0.164	24	10	15	

Minimum & Maximum Cover For 9" x 2 1/2" Aluminum Structural Plate Pipe-Arch*					
Span x Rise (ft-in x ft-in)	Corner Radius (in.)	Minimum Gage (in.)	Min. Cover (ft)	Max. Cover in Feet For Soil Bearing Capacity of:	
				2 Tons/11'	3 Tons/11'
5 - 11 x 5 - 5	31.8	0.100	2	24**	24**
6 - 11 x 5 - 9	31.8	0.100	2	22**	22**
7 - 3 x 5 - 11	31.8	0.100	2	20**	20**
7 - 9 x 6 - 0	31.8	0.100	2	28**	18**
8 - 5 x 6 - 3	31.8	0.100	2	17**	17**
9 - 3 x 6 - 5	31.8	0.100	2	15**	15**
10 - 3 x 6 - 9	31.8	0.100	2	14**	14**
10 - 9 x 6 - 10	31.8	0.100	2	13**	13**
11 - 5 x 7 - 1	31.8	0.100	2	12**	12**
12 - 7 x 7 - 5	31.8	0.125	2	14	16**
12 - 11 x 7 - 6	31.8	0.150	2	13	14**
13 - 1 x 8 - 2	31.8	0.150	2	13	18**
13 - 11 x 8 - 5	31.8	0.150	2	12	17**
14 - 8 x 9 - 8	31.8	0.175	2	12	18
15 - 4 x 10 - 0	31.8	0.175	2	11	17
16 - 1 x 10 - 4	31.8	0.200	2	10	16
16 - 9 x 10 - 8	31.8	0.200	2.17	10	15
17 - 3 x 11 - 0	31.8	0.225	2.25	10	15
18 - 0 x 11 - 4	31.8	0.255	2.25	9	14
18 - 8 x 11 - 8	31.8	0.250	2.33	9	14

*Longitudinal seams use (5 1/3)
3/4" dia. bolts per foot.

**Fill limited by the seam strength of the bolts,
3/4" dia. bolts per foot.

METAL THICKNESSES & GAGES	
ALUMINUM	GAGE NO. (For Info Only)
0.060	16
0.075	14
0.105	12
0.135	10
0.164	8

© This column shall not be used unless specified
on the plans or approved by the Regional
Geotechnical Engineer.

REVISIONS		
Date	Description	By
8/10/00	Pipe Tables & G. Notes.	DFD
10/31/03	Pipe Table Updates &	LRG
	New Sheet 4	

Sheet 1 of 4

State of Alaska
Department of Transportation
& Public Facilities


PIPE AND ARCH TABLES

Date	10/31/03
------	----------

GENERAL NOTES


- 1. All materials and workmanship shall be in accordance with the State of Alaska Standard Specifications for Highway Construction.
- 2. For foundation and structural backfill details see Standard Drawing "Culvert Pipe & Arch Installation Details".
- 3. Pipe cover height is measured from top of the pipe to top of rigid pavement, or to the top of subgrade for flexible pavement. In all cases the minimum cover shall be no less than 2 ft. Where loads traverse the culvert during construction minimum cover shall be no less than 4 ft.

Maximum Cover for Type S Corrugated Polyethelene Pipe	
Size (in.)	Max. Cover (ft.)
12	30.0
15	30.0
18	30.0
24	30.0
30	30.0
36	30.0
40	20.0
48	20.0


REVISIONS		
Date	Description	By
10/31/03	New Sheet 4.	LRG
Sheet 3 of 4		
State of Alaska Department of Transportation & Public Facilities		
PIPE AND ARCH TABLES		
<div>APPROVED</div> <div></div> <div>Date 10/31/03</div>		

GENERAL NOTES:


1. Type FD Cast Device Box w/green pilot light on the termination post shall be located a minimum of 6" above high water.

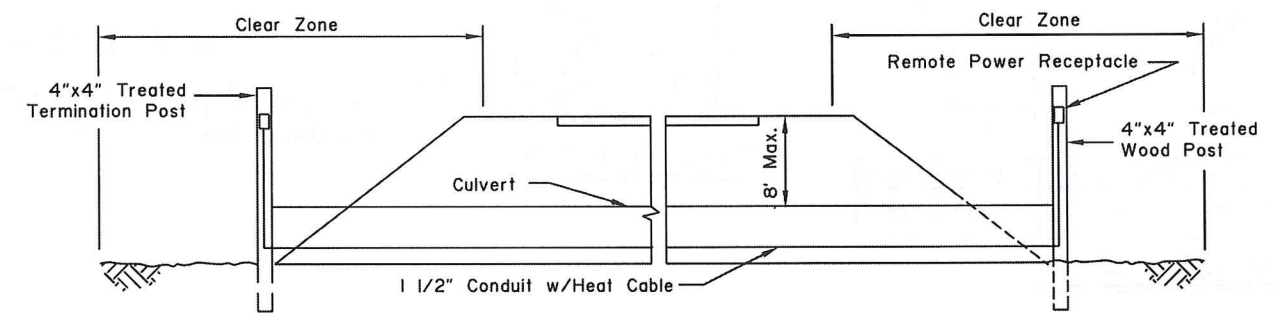


SECTION THRU CULVERT
(Low Fill)

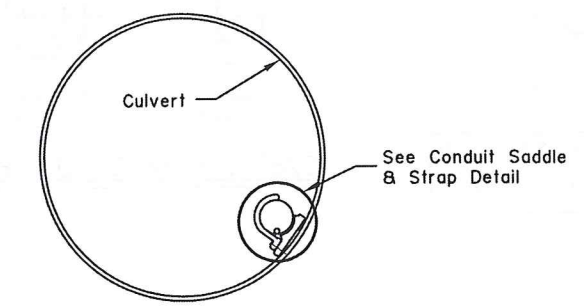


CULVERT CROSS SECTION

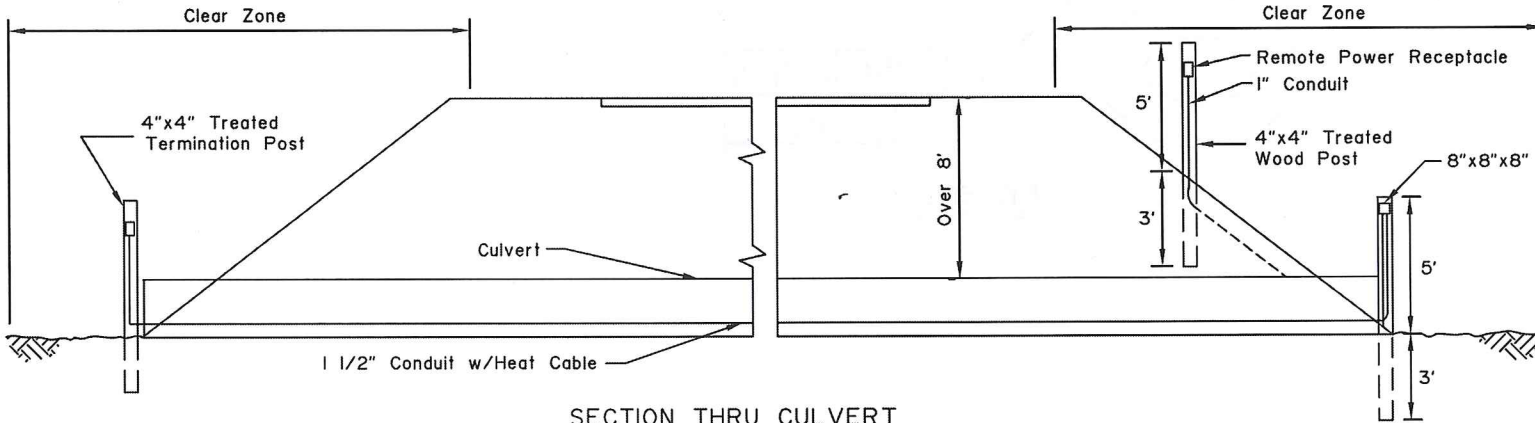

SECTION THRU CULVERT
(High Fill)

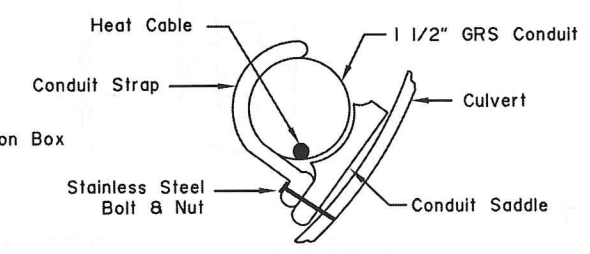


CONDUIT SADDLE &
STRAP DETAIL

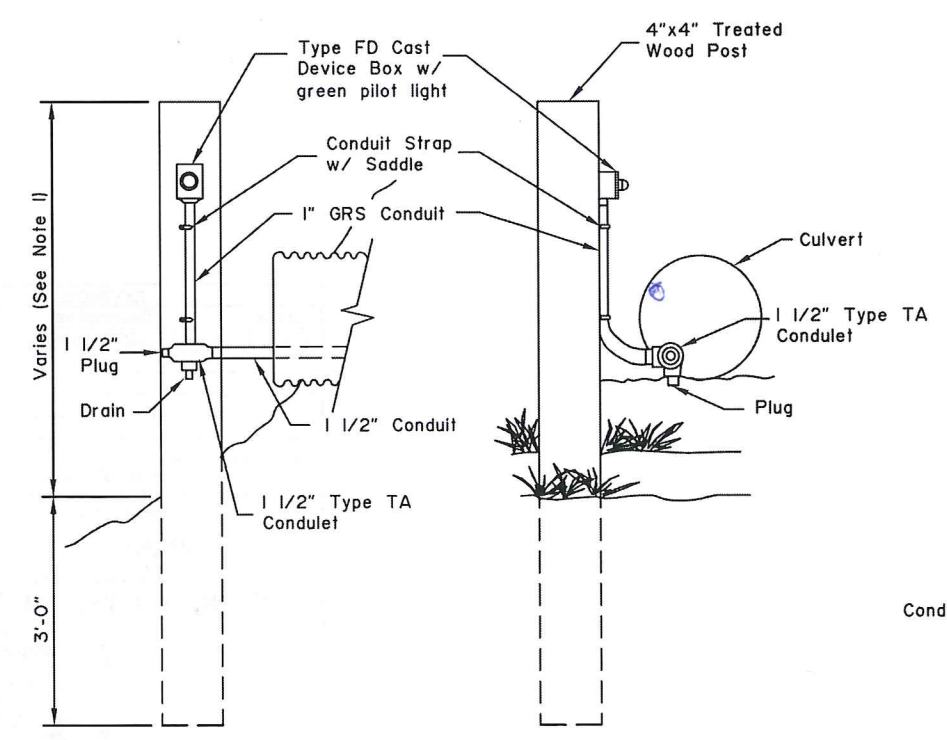

FRONT VIEW


PROFILE VIEW

TERMINATION POST DETAIL

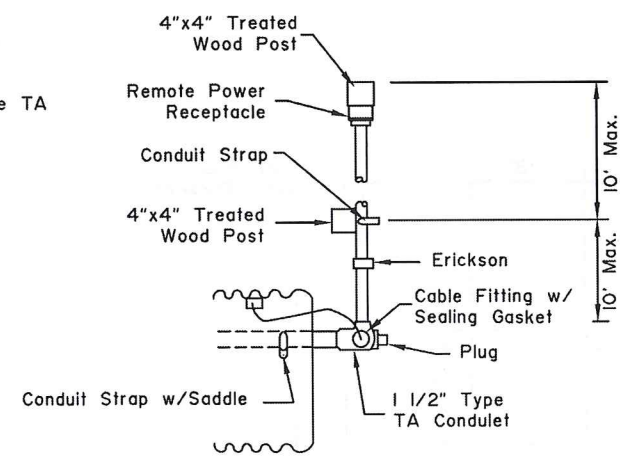

PLAN VIEW

REMOTE CULVERT ENTRY DETAIL

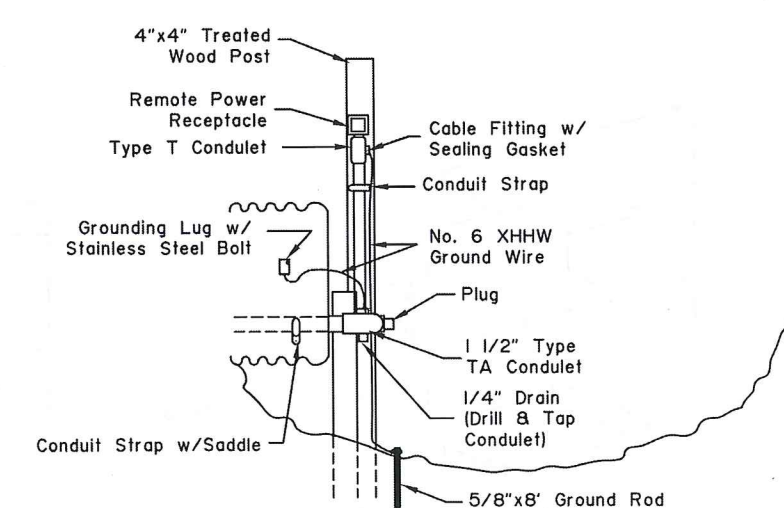

ELEVATION

REVISIONS		
Date	Description	By
3/1/83	Revised Gen. Notes	WJF/HK
4/1/93	Modified Drawing	Gdo

State of Alaska
Department of Transportation
& Public Facilities

REMOTE THAW WIRE INSTALLATION



APPROVED











Date

7/15/82

GENERAL NOTES:

1. Provide hardware compliant with the AASHTO/AGC/ARTBA "A Guide to Standardized Highway Barrier Hardware, latest edition.
2. Install back-up plates between blockouts and w-beam or thrie-beam rail at intermediate (non-splice) posts when steel blockouts are used but not with wood, rubber, plastic, or other approved blockouts.
3. Provide Thrie beam and W-beam compliant with AASHTO M180A. Use 12 gauge (0.105") thick steel for both.

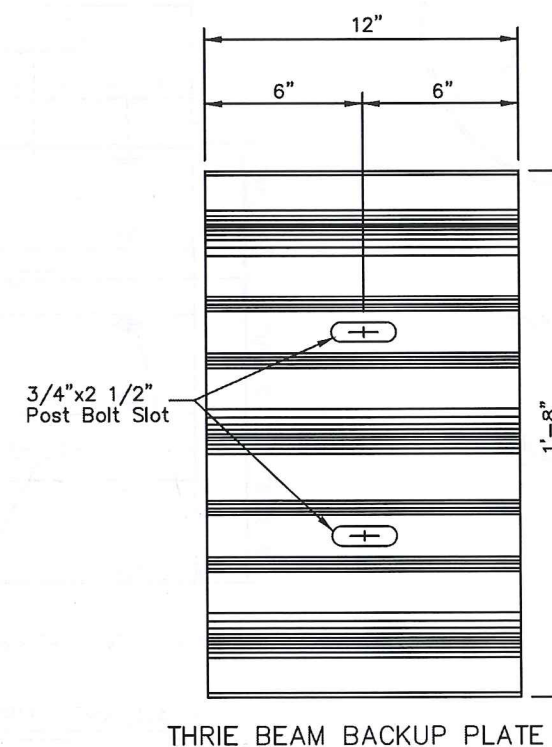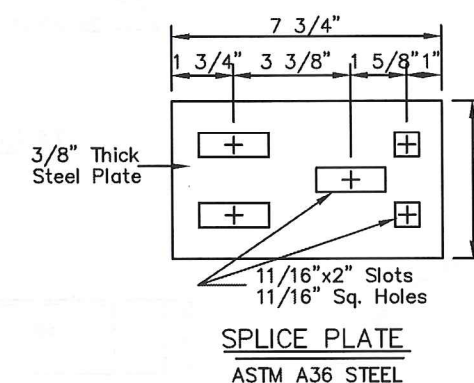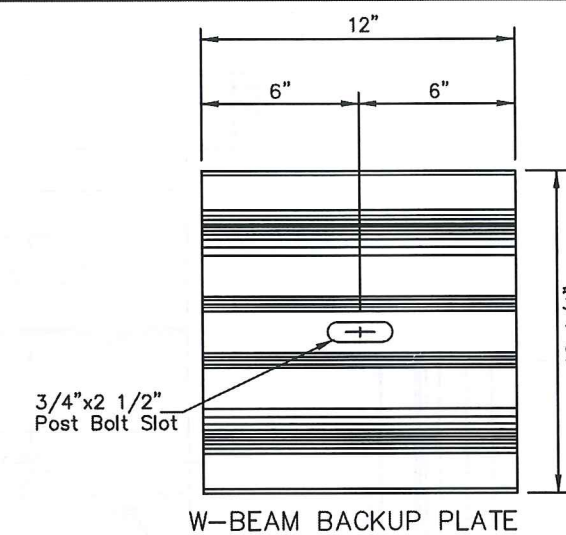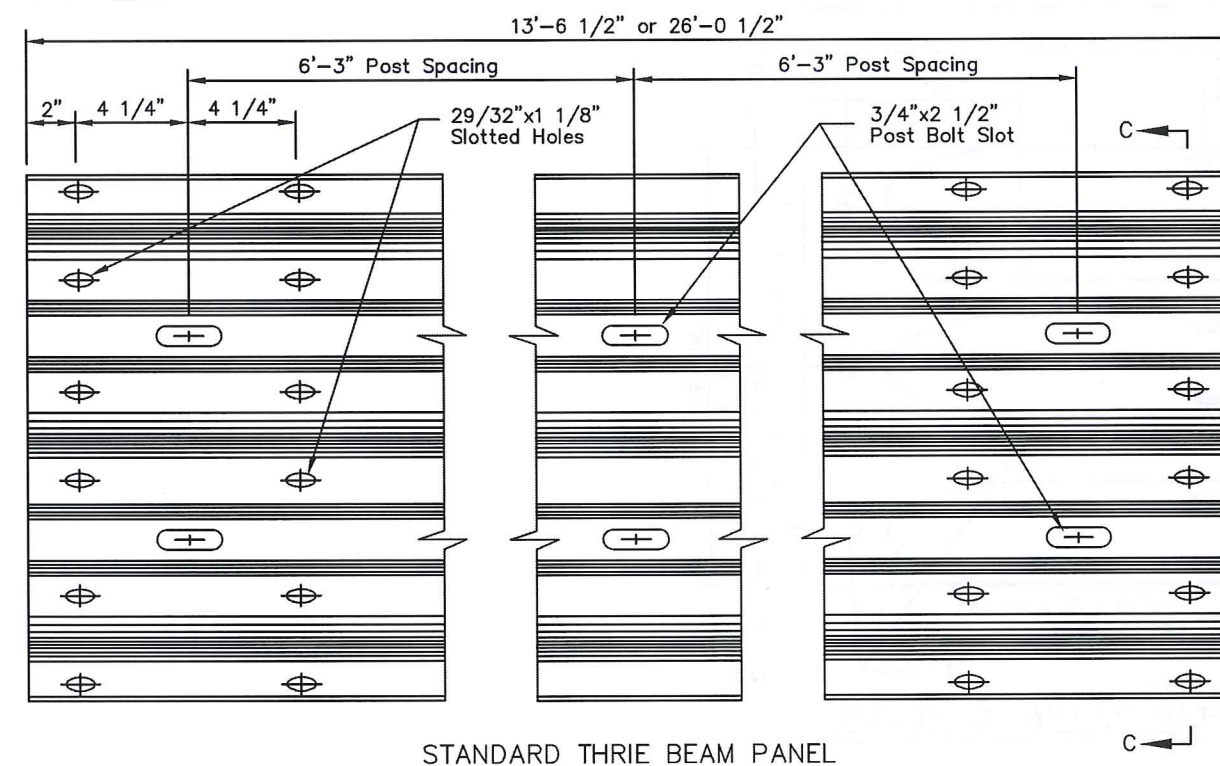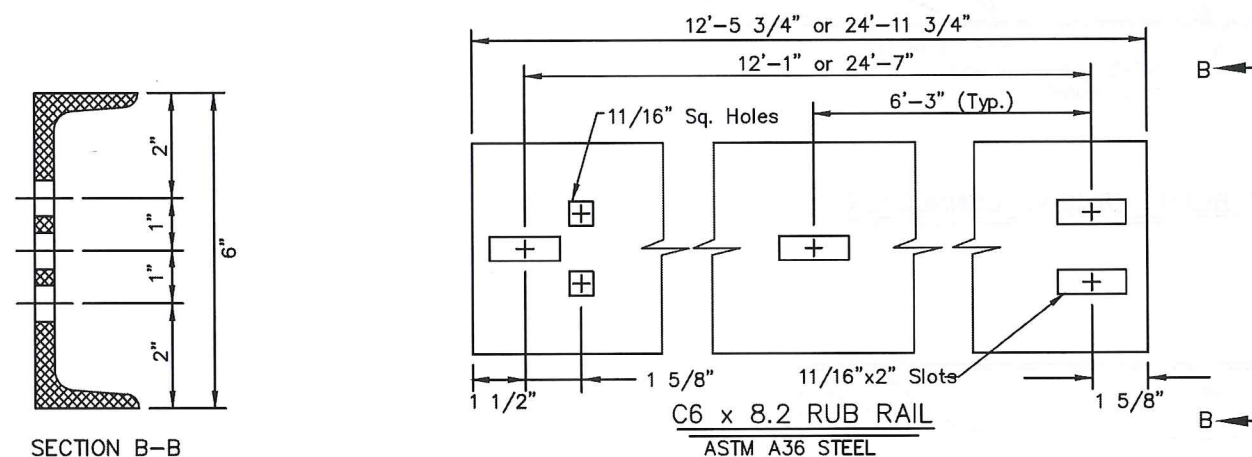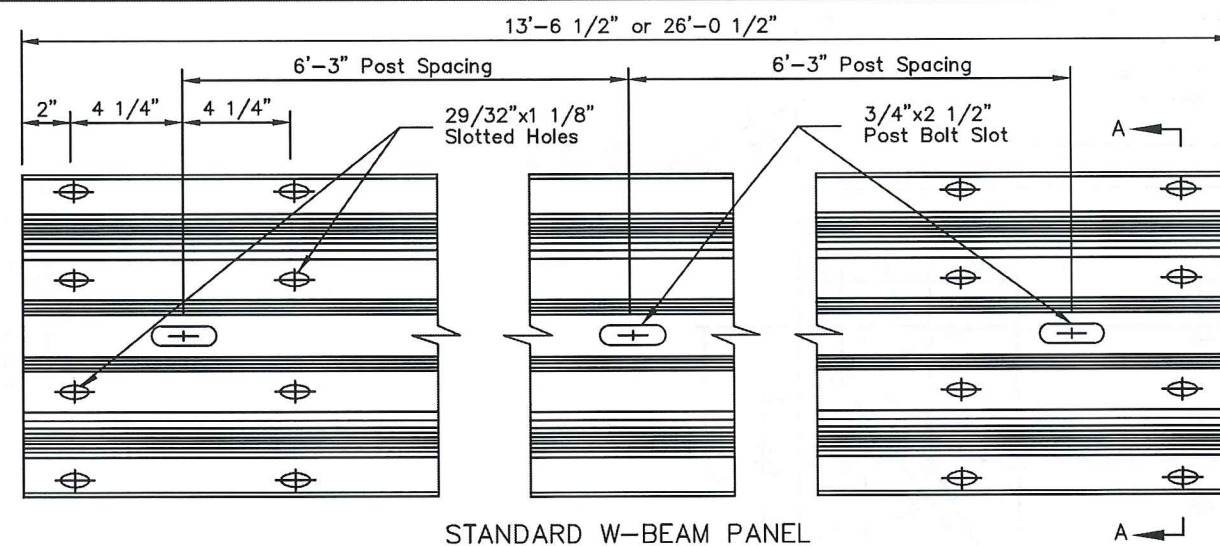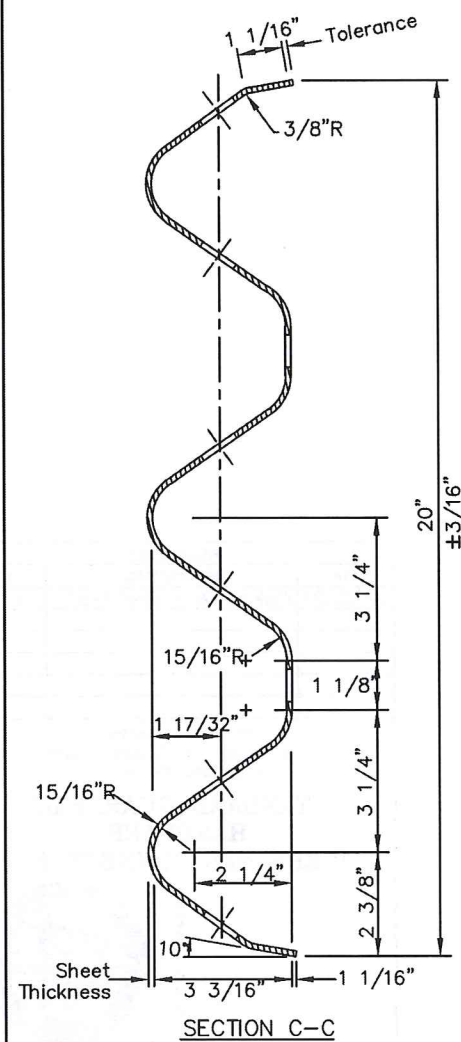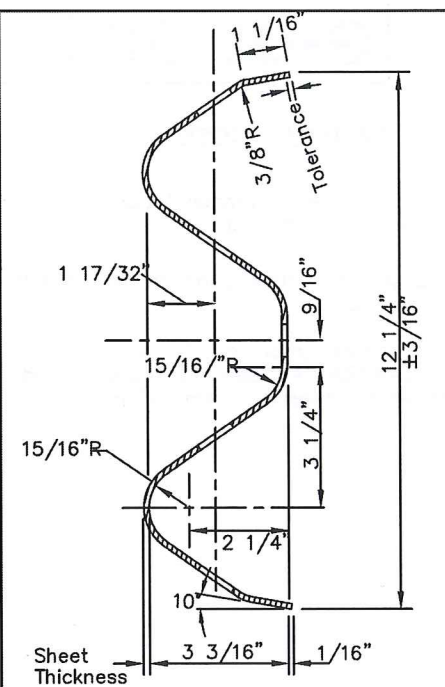

REVISIONS		
Date	Description	By
4/28/10	Revise General Notes	KJS


State of Alaska
Department of Transportation
& Public Facilities
**STANDARD GUARDRAIL
HARDWARE
(RAILS AND SPLICES)**

APPROVED
Date 5/31/12


49th
Kurt J. Smith
4/28/10

GENERAL NOTES:


1. Cable Anchor Plate may be formed in single unit or welded fabrication.
2. Anchor Cable Assembly shall conform to AASHTO M-30 with Type II Wire Rope.
3. Sleeve for Wood Posts shall conform to the requirements of ASTM A120 and shall be of 2-inch galvanized standard pipe. Sleeve shall be a tight, pressed fit in post.
4. Bolts, nuts and washers shall conform to ASTM A-325 and galvanized in accordance with ASTM A-153.
5. Radius ID plates shall be attached to all shop-bent guardrail sections. They shall be bolted to the back side of the guardrail panel with the lower splice bolt nearest the P.C. of the radius.
6. Rail bend radius in feet shall be shown as "XX" on the radius ID plate. Digits shall be etched or stamped and have a min. height of 1 1/2" and a max. width of 3/4". The plate shall be galvanized after digits are marked.
7. All covered hardware shall comply with the AASHTO/AGC/ARTBA "A Guide to Standardized Highway Barrier Hardware", latest edition.

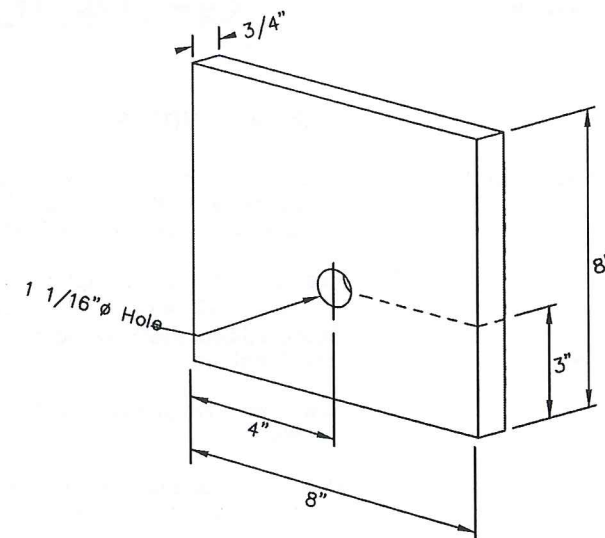


BEARING PLATE for CRT TERMINAL ANCHOR

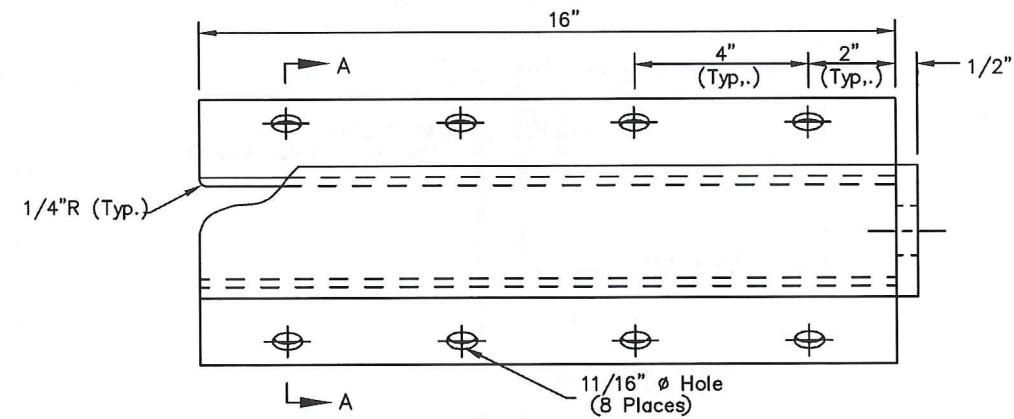


CABLE ANCHOR PLATE

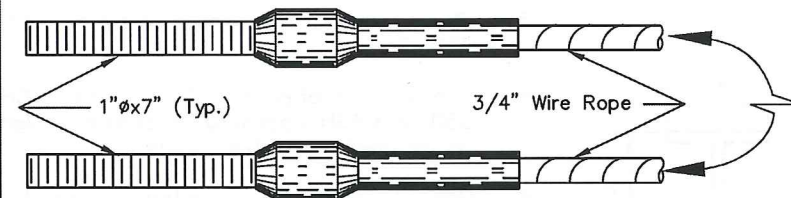

SWAGED FITTING DETAIL

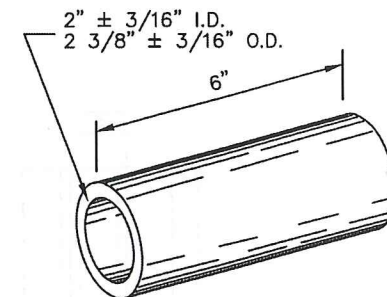


SLEEVE DETAIL

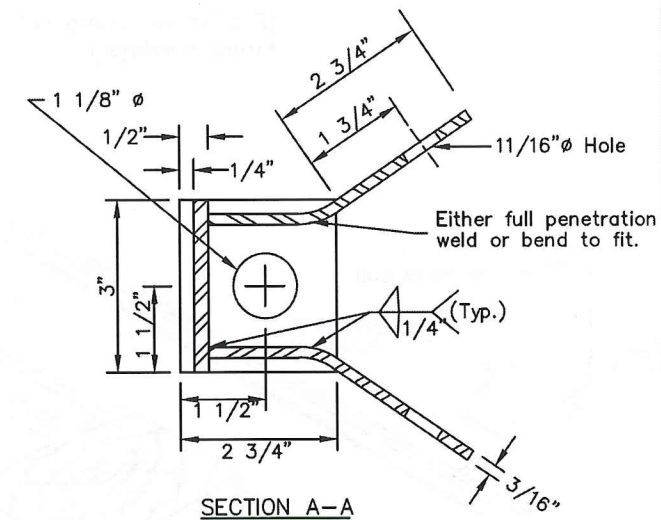


SECTION A-A


CONTROLLED RELEASE TERMINAL HARDWARE DETAILS

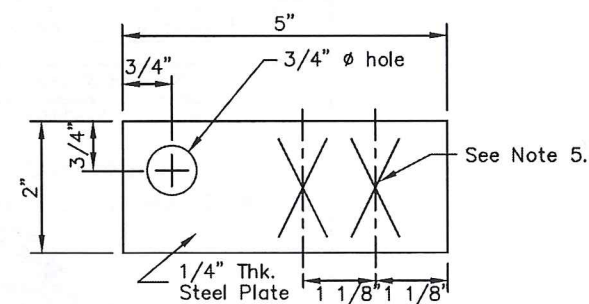

RADIUS I.D. PLATE

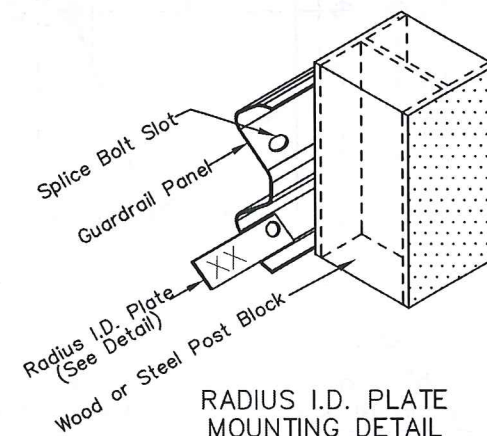

RADIUS I.D. PLATE MOUNTING DETAIL

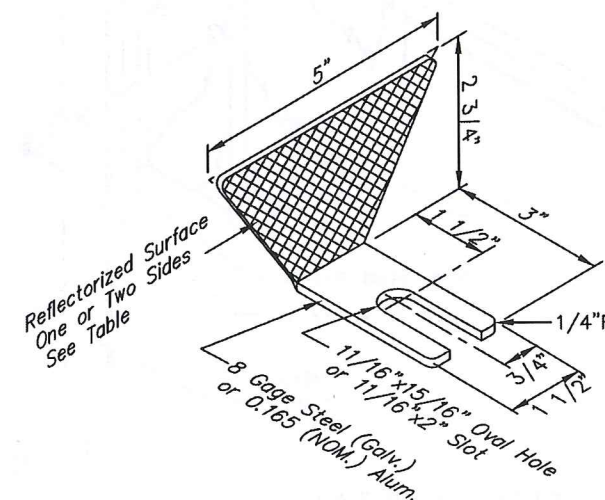

GUARDRAIL REFLECTOR

Type	Guardrail Color	Reflectors
A	White	Front & Rear
B	White	Front
C	Yellow	Front
D	Yellow	Front & Rear

Date	REVISIONS Description	By
3/15/99	Delete BCT Hardware	KJS


State of Alaska
Department of Transportation
& Public Facilities
**STANDARD GUARDRAIL
HARDWARE
(MISCELLANEOUS)**




Date 5/31/12

GENERAL NOTES:


- 1. This drawing is to be used for post length determination only. See the plans for slopes and behind-post embankment widths.
- 2. To determine post length, identify the case that matches site conditions and read the length corresponding to the pertinent guardrail type.
- 3. These dimensions apply to both curbed and uncurbed sections.

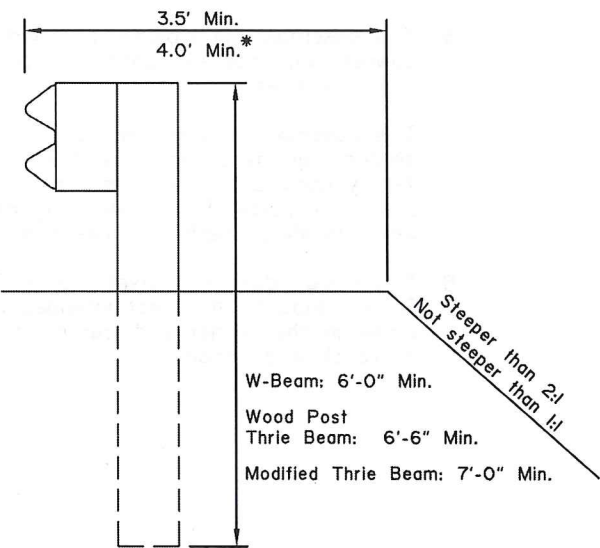

CASE 1

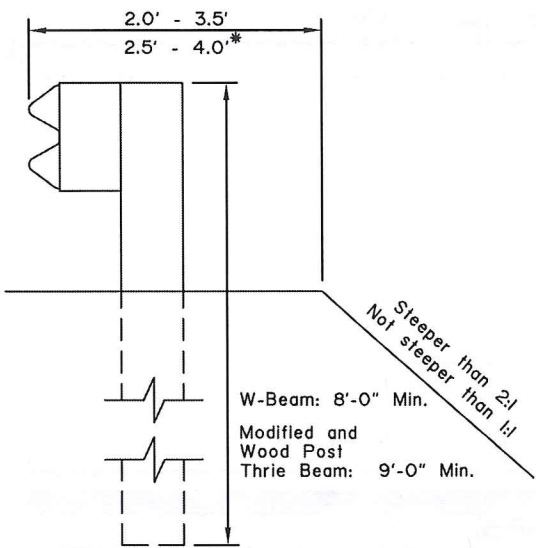

CASE 2

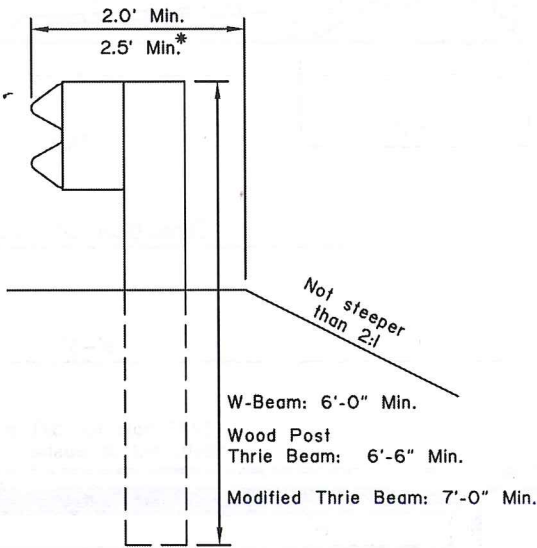

CASE 3

*
with Modified Thrie Beam'

REVISIONS		
Date	Description	By
12/2/99	Delete Case 4,5, and 6	KJS

State of Alaska
Department of Transportation
& Public Facilities

BEAM GUARDRAIL
POST INSTALLATION


A
P
P
R
O
V
E
D



Date 3/15/99

GENERAL NOTES:

1. This terminal (exclusive of the anchor) may be constructed using steel or wood posts and may be anchored either with steel posts or with a concrete block.
2. W-beam, block, and post details not shown here shall conform to the applicable G-04 drawing except for post length, which is 8'-0" for all posts except the three that may be used in the optional post anchor. Those shall be 6'-0" long.
3. The offset to the bottom of the ditch varies. However, ditch slopes shall be no steeper than those shown.
4. All covered hardware shall comply with the AASHTO/AGC/ARTBA "A Guide to Standardized Highway Barrier Hardware", latest edition.
5. This terminal has passed NCHRP 350, Test level 3.

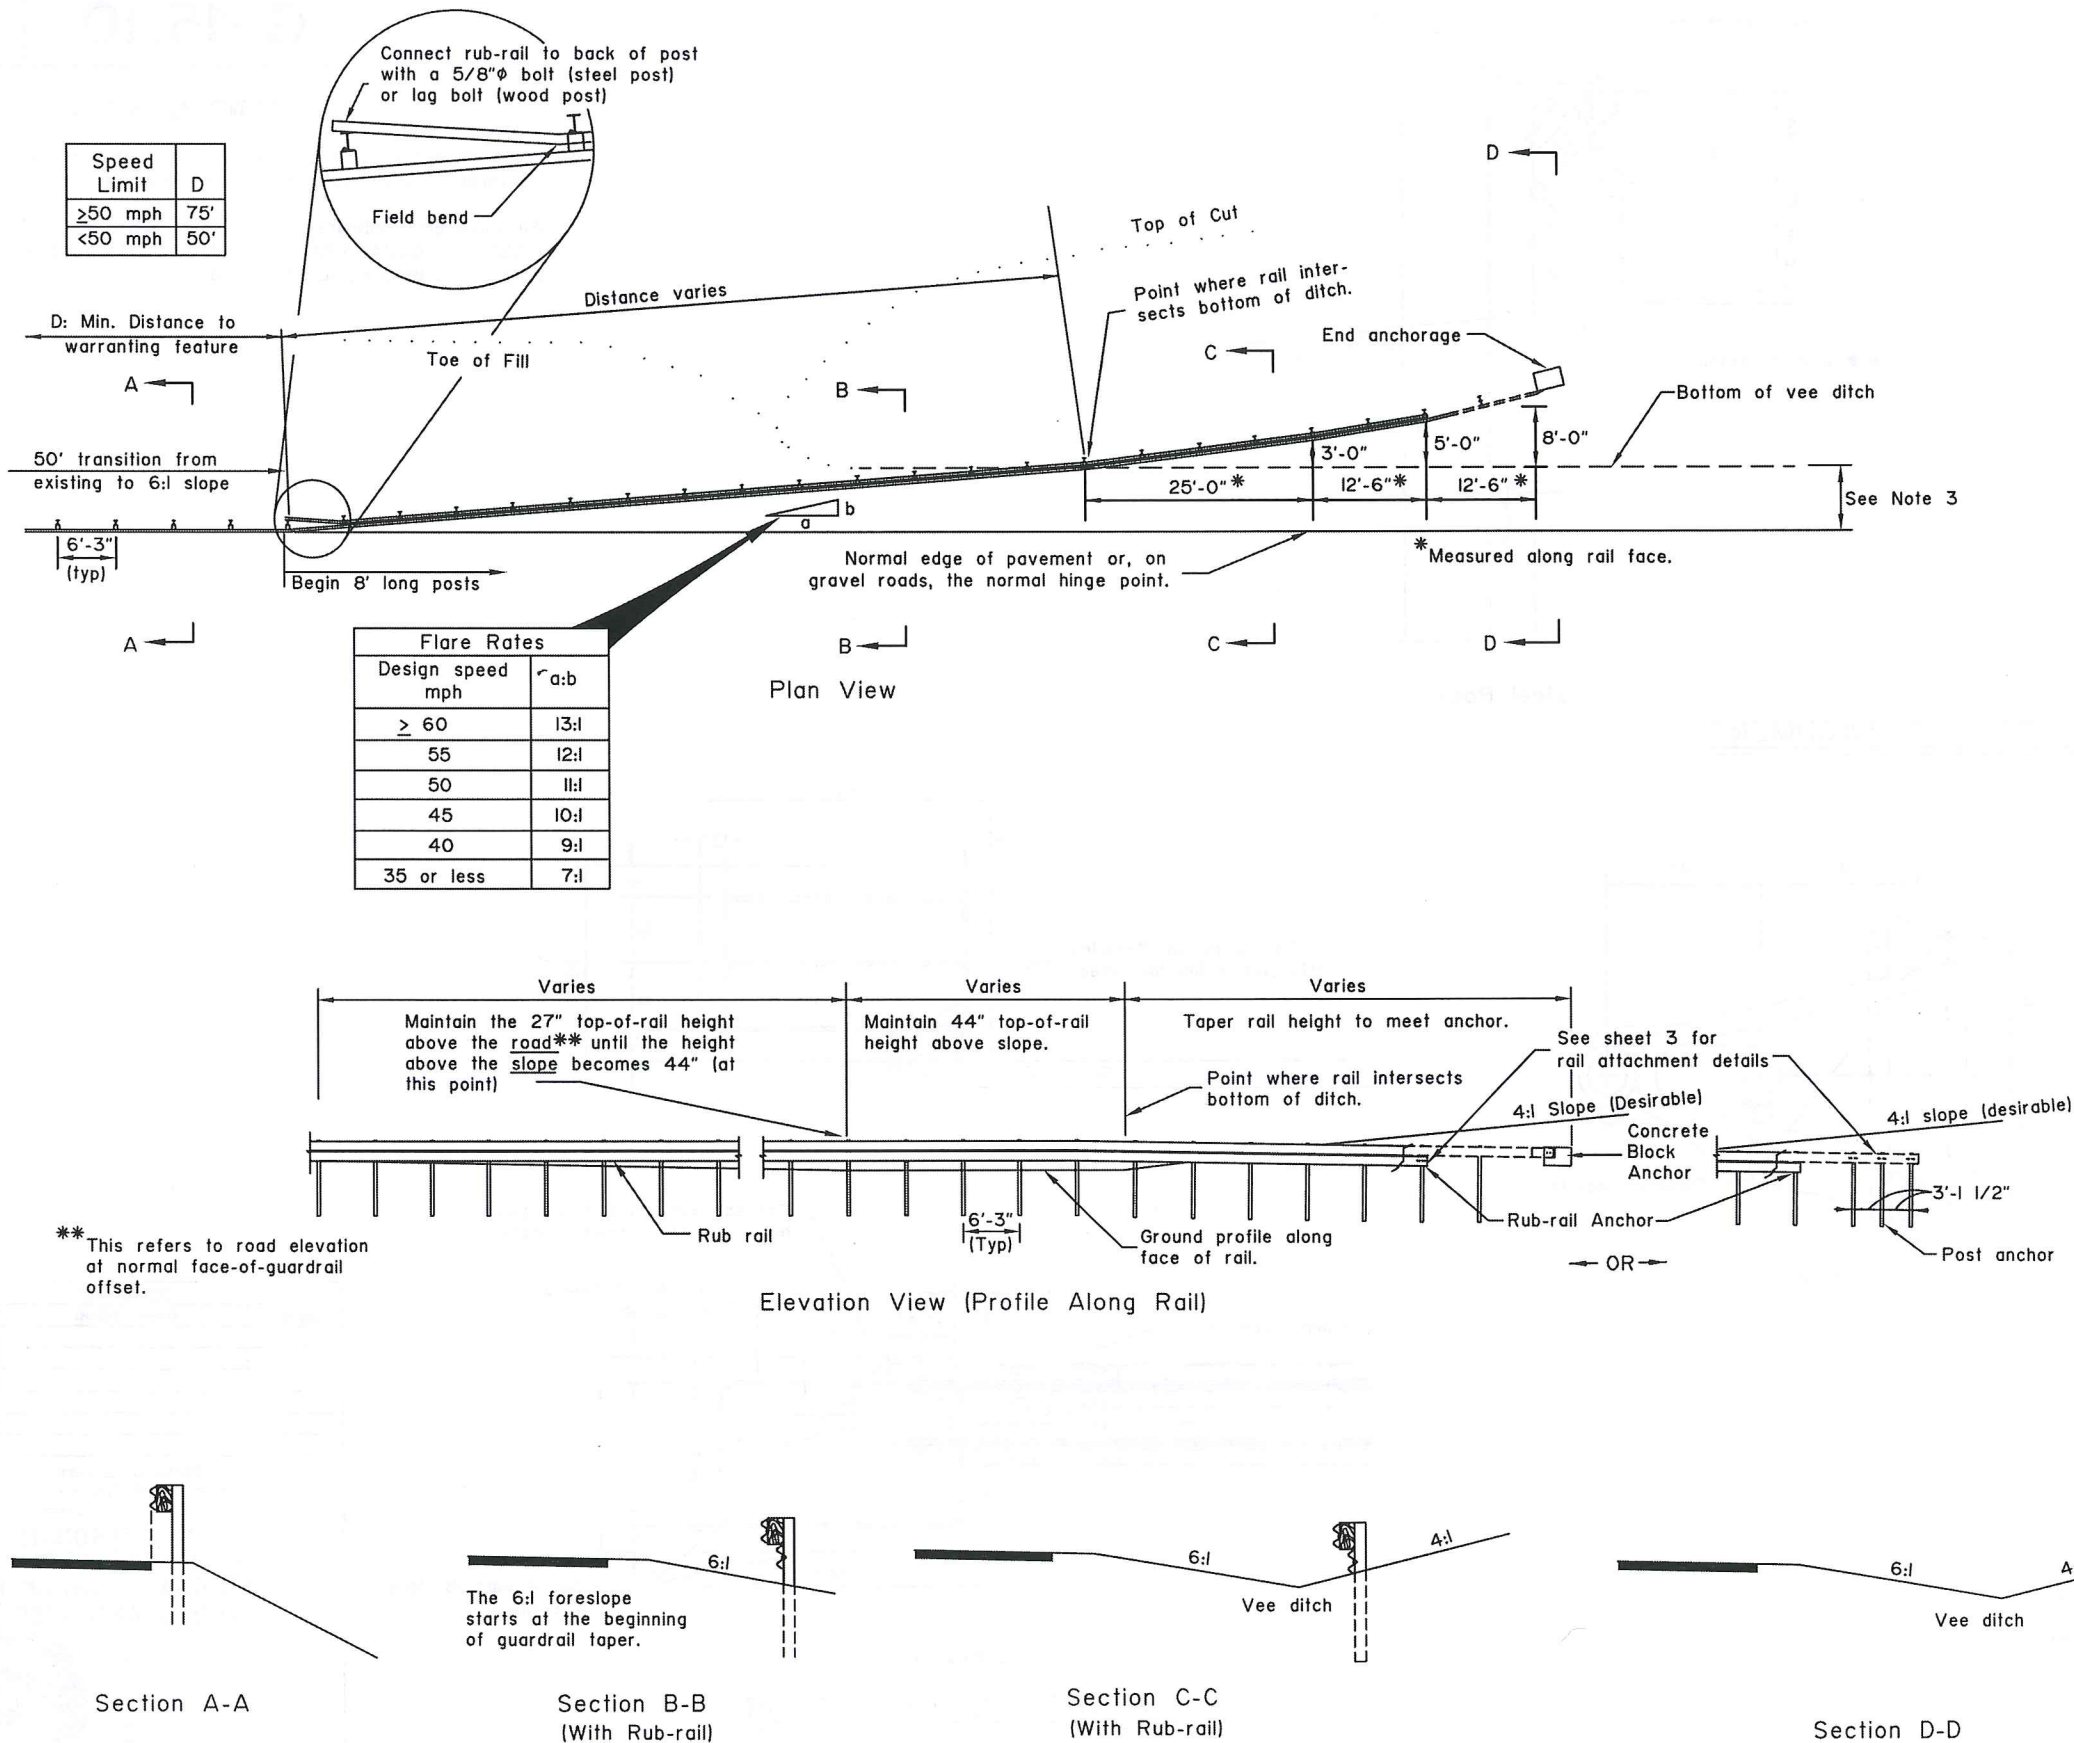

REVISIONS		
Date	Description	By

State of Alaska
Department of Transportation
& Public Facilities

**BEAM GUARDRAIL
BURIED-IN-BACKSLOPE
TERMINAL**





APPROVED

3/15/99


Date

GENERAL NOTES:


1. W-Beam, block, and post details not shown here shall conform to the applicable G-04 drawing.
2. All covered hardware shall comply with the AASHTO/AGC/ARTBA "A Guide To Standardized Highway Barrier Hardware", latest edition.

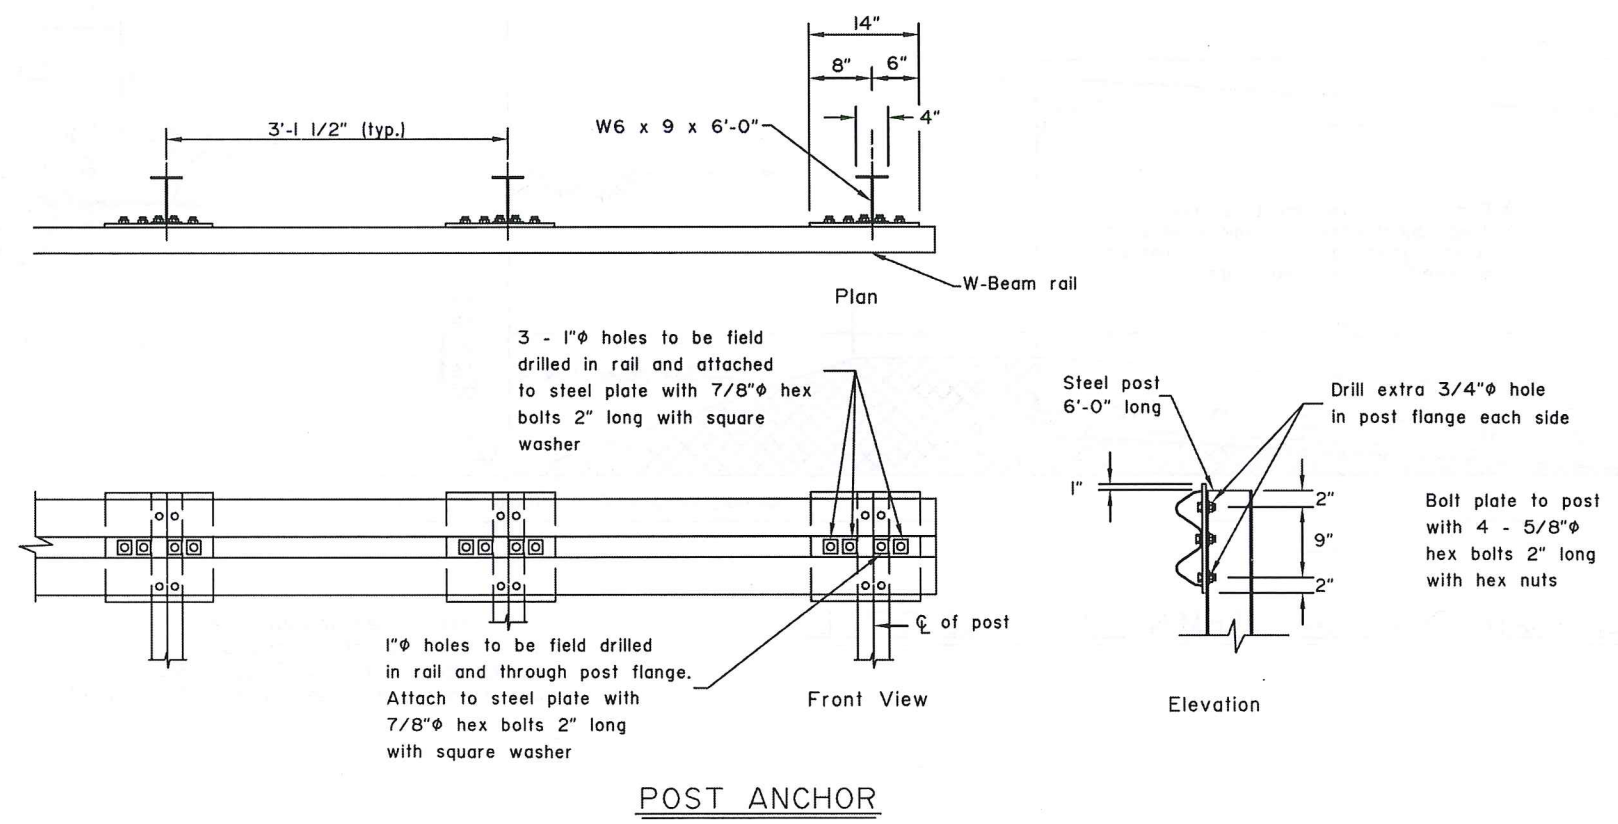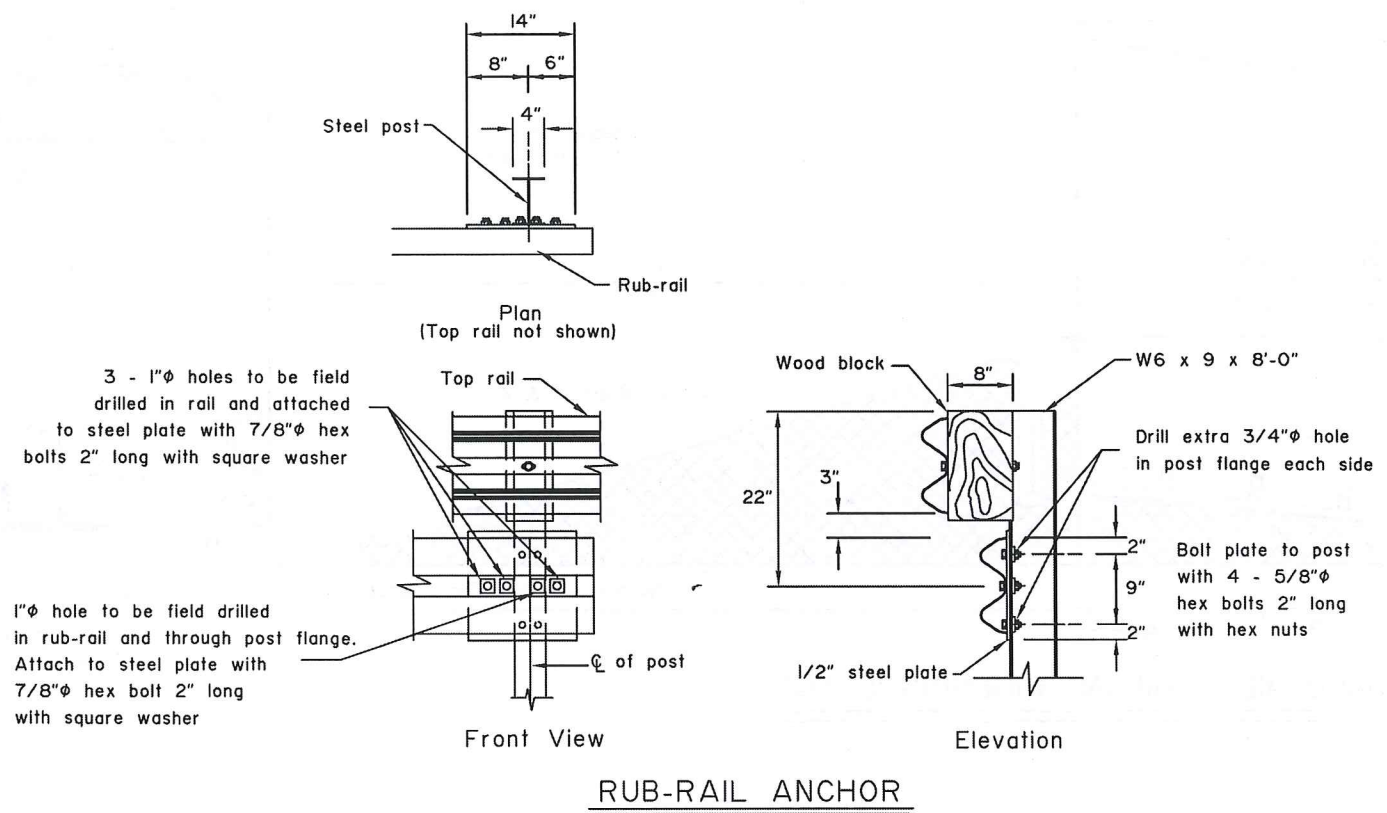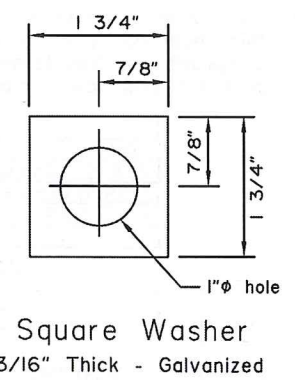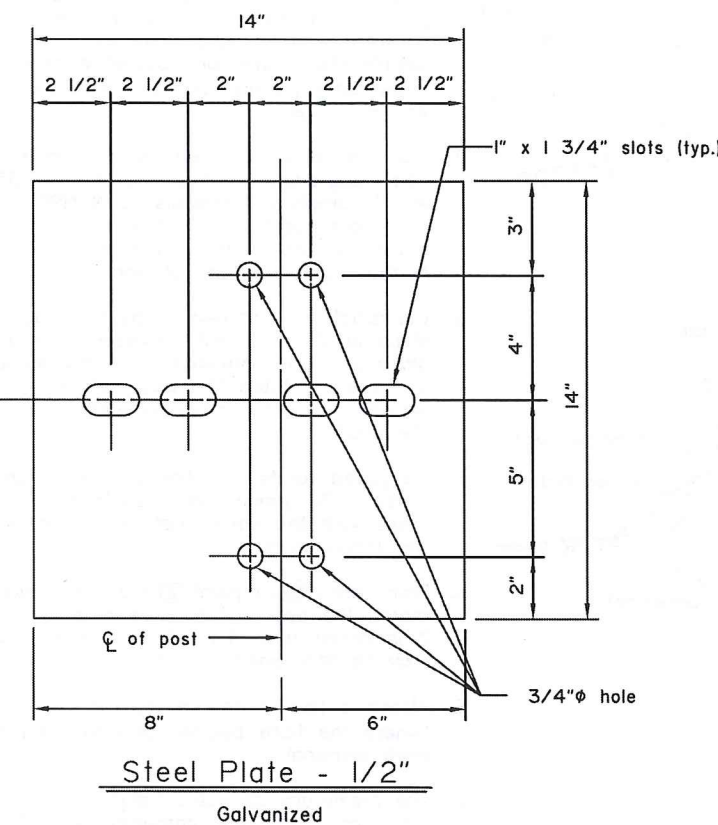


REVISIONS		
Date	Description	By
State of Alaska Department of Transportation & Public Facilities		
BEAM GUARDRAIL BURIED-IN-BACKSLOPE TERMINAL RUB-RAIL AND POST ANCHORS		
APPROVED		
Date 3/15/99		

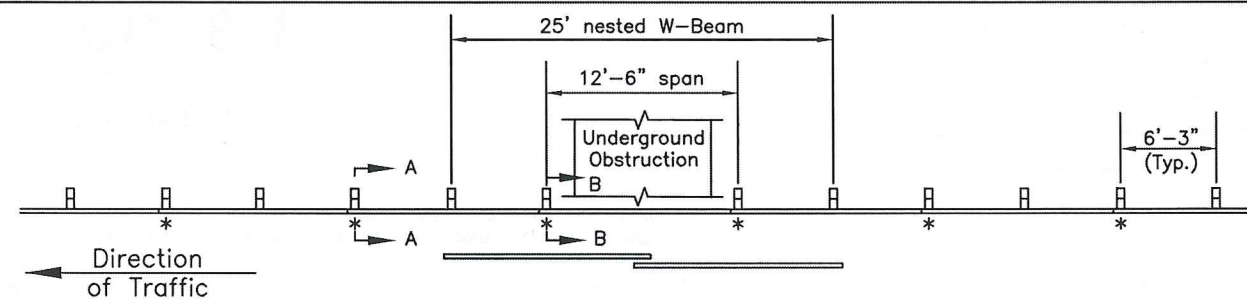


CASE A – ONE POST OMITTED (NESTED RAIL SPLICE AT OMITTED POST)
For obstruction widths up to 10'-6"

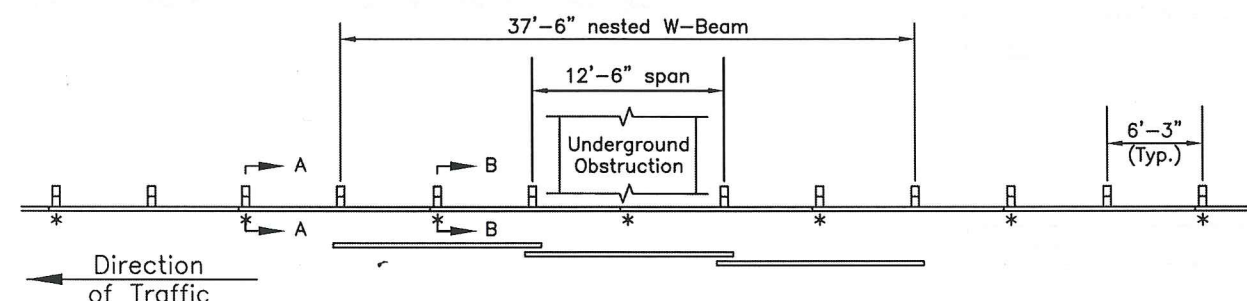

CASE B – ONE POST OMITTED (NESTED RAIL SPANS OMITTED POST)
For obstruction widths up to 10'-6"

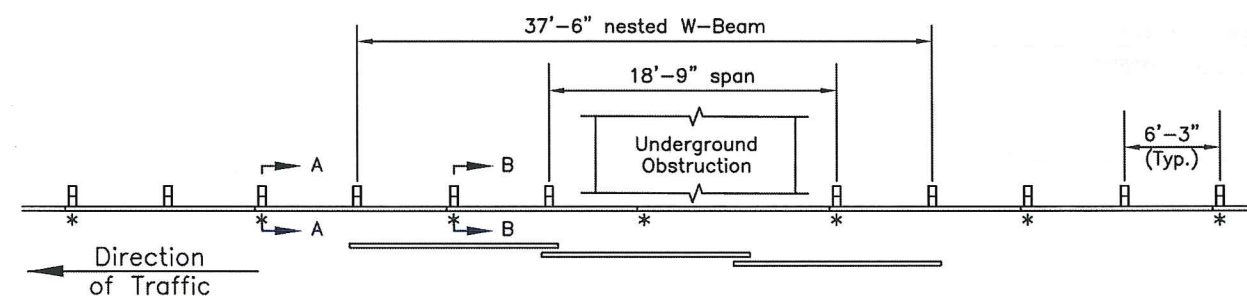


CASE C – TWO POSTS OMITTED
For obstruction widths from 10'-6" to 16'-9"

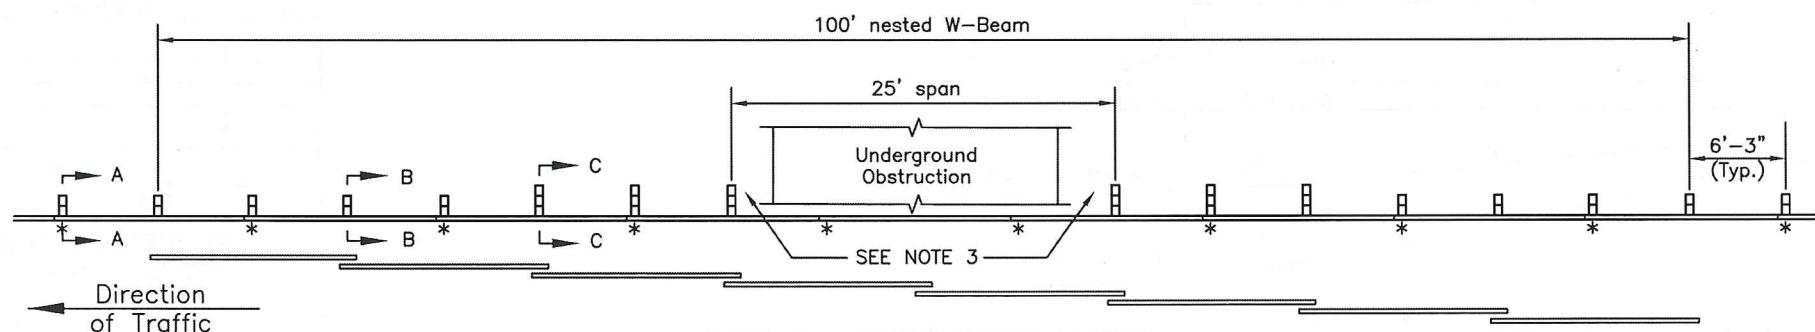


CASE D – THREE POSTS OMITTED
For obstruction widths from 16'-9" to 20'-6"


* Designates Splice Location

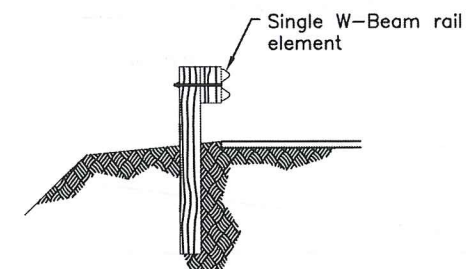

SECTION A-A

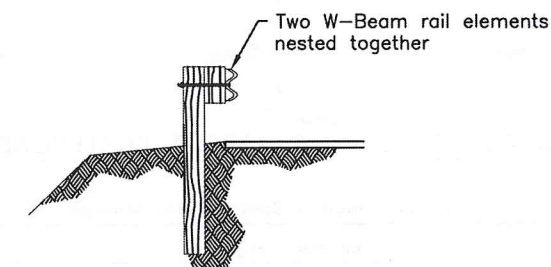

SECTION B-B

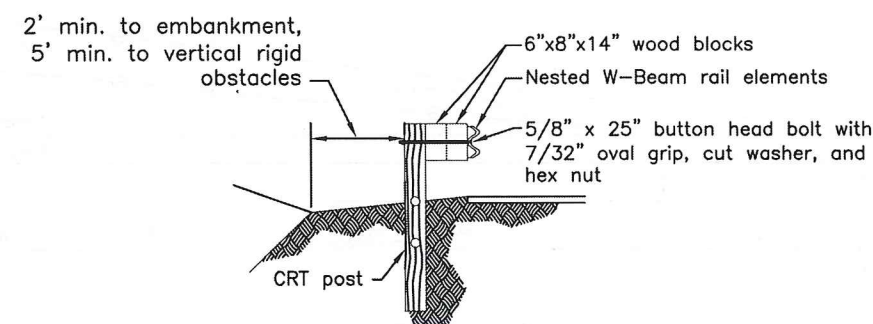

SECTION C-C

CROSS SECTIONS


GENERAL NOTES

1. See Standard Drawings G-00, G-04, G-10 for additional details, and G-25 Sheet 1 of 3 for CRT post details.
2. For one-way traffic locations Case D may be modified so that only the posts trailing the span are CRT posts with double blocks.
3. In Case D only, provide 2' minimum clearance between posts and underground obstruction.
4. Standard steel posts with standard wood blocks (or NCHRP 350 compliant synthetic blocks) may be used for all posts except those indicated to be CRT posts.
5. Install nested rail element with leading edge lapped behind primary rail element.
6. Cases A and B were tested under NCHRP 230 guidelines but the FHWA considers them equivalent to an NCHRP 350 Test Level 2 design. Case C has not been tested (as of March, 03) but the FHWA considers it equivalent to an NCHRP 350 Test Level 3 design. Case D is NCHRP 350 Test Level 3 tested and approved.

REVISIONS		
Date	Description	By
Sheet 1 of 1		
State of Alaska Department of Transportation & Public Facilities		
LONG SPAN W BEAM GUARDRAIL		
<div style="display: flex; justify-content: space-around; align-items: center;"> <div style="text-align: center;"> APPROVED </div> <div style="text-align: center;"> DATE </div> </div>		
Date 2/28/03		

GENERAL NOTES:

1. For Structures under 200' total length: provide 1 monument.
2. For Structures 200' or over: provide 2 Monuments.
3. Monuments shall be located as directed by the Engineer.

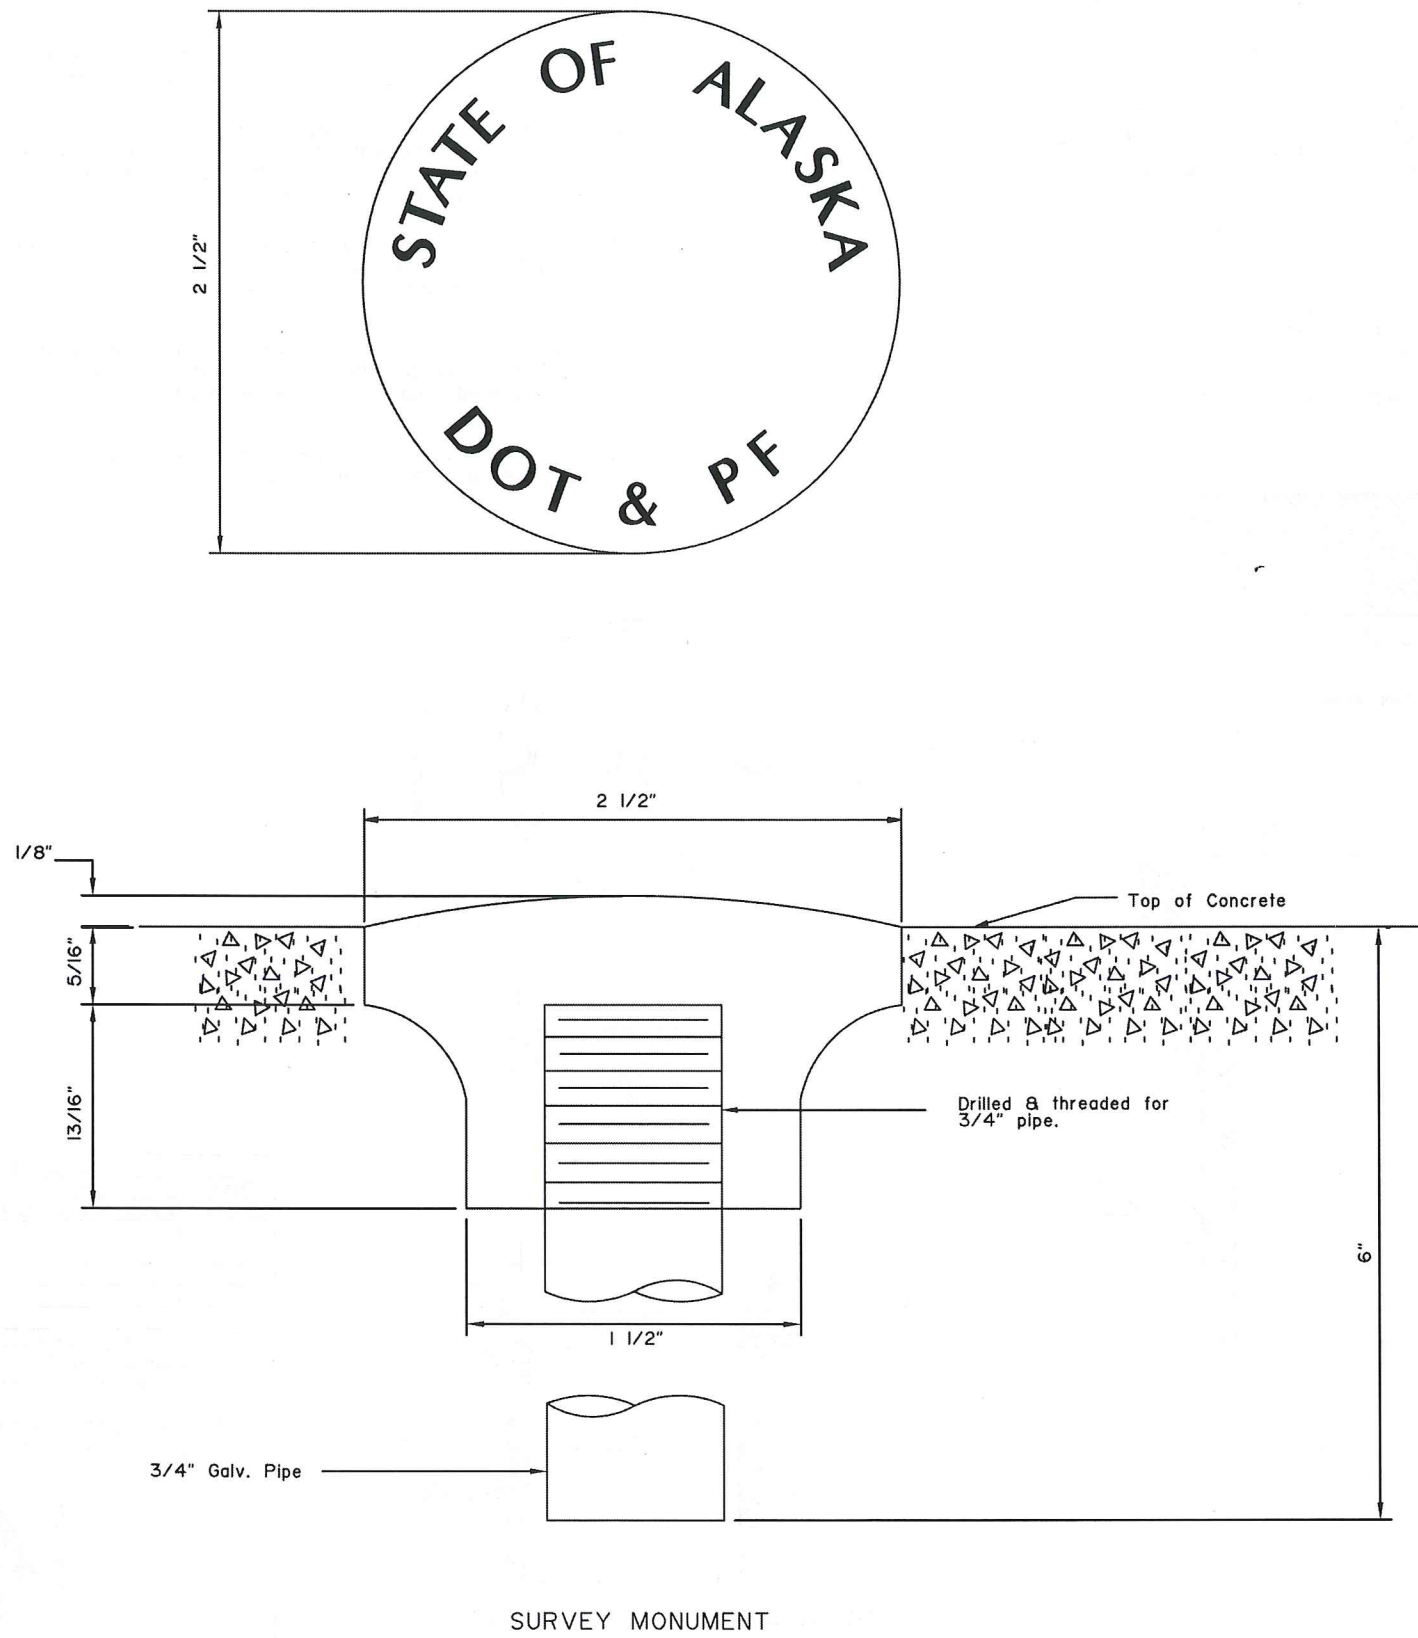

REVISIONS		
Date	Description	By
5/15/89	Revised Cap Markings	Gdo

State of Alaska
Department of Transportation
& Public Facilities


SURVEY MONUMENT

APPROVED

Date 7/15/82


49TH

LOREN L. STANISSEY
CE-3395

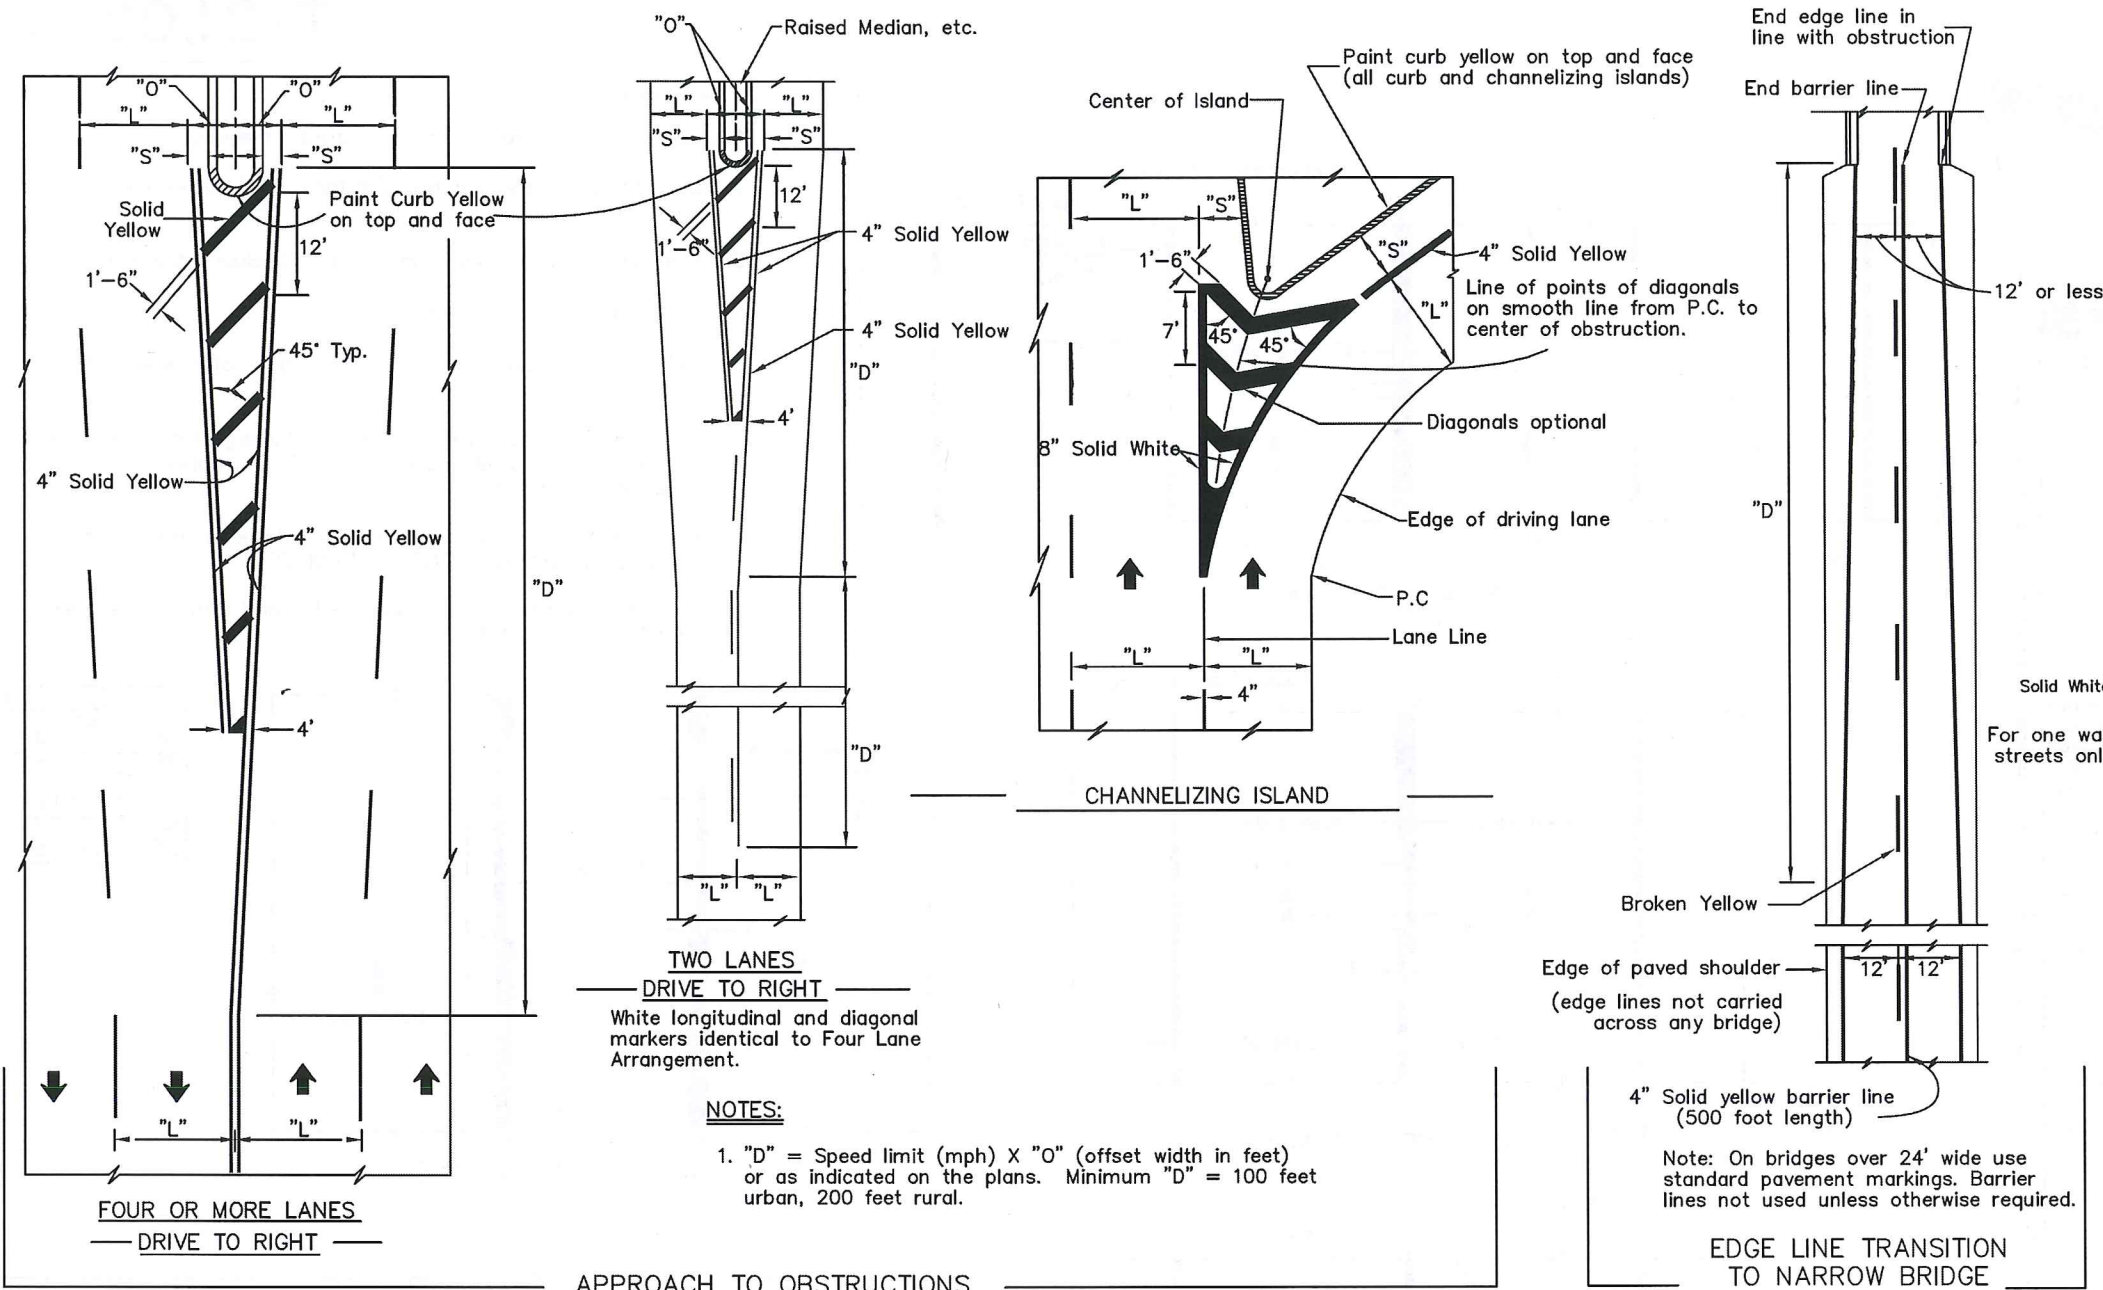


- NOTES:
1. All markings solid white unless indicated otherwise.
 2. On 4-lane roadways place railroad crossing approach markings in each lane of the approach.
 3. Locate Stop Bar 15' from railroad track or 8' from gate, if present.
 4. Place edge lines and lane lines on a uni-directional approach in a normal manner except that the lane line(s) shall be solid 4" white in lieu of broken for a distance of (D+60') in advance of the stop bands.

POSTED LIMIT	D
30 M.P.H.	225'
40	350'
50	475'
60	625'

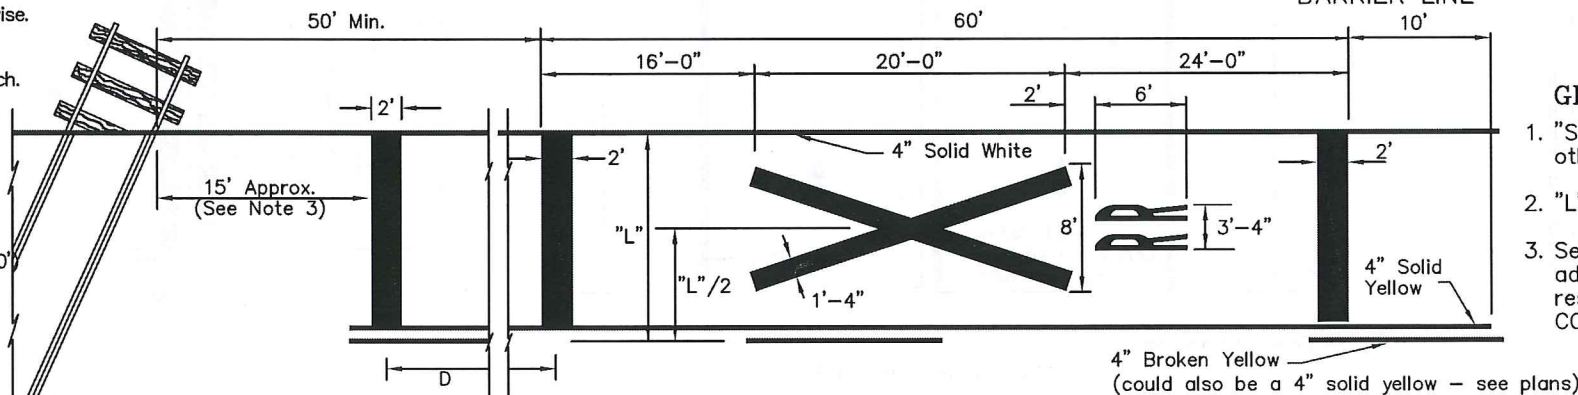

APPROACH TO RAILROAD CROSSING ON 2 LANE 2 WAY HIGHWAY

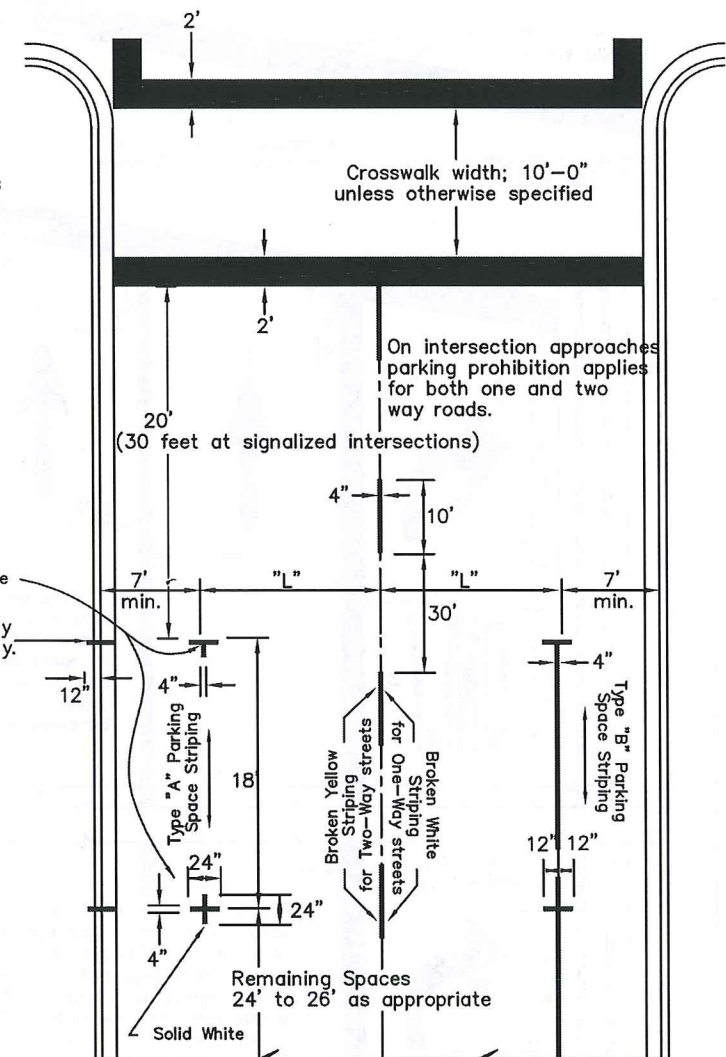

CENTERLINES FOR TWO LANE TWO WAY URBAN ROADS-PARKING LIMIT LINES

GENERAL NOTES:


1. "S"—offset distance as designated, otherwise 1 to 2 feet.
2. "L"—driving lane width.
3. See Alaska Traffic Manual for additional instruction and/or restriction on the use of TRAFFIC CONTROL DEVICES.

NOT TO SCALE

REVISIONS		
Date	Description	By
2/15/00	Changed "RR" location	KJS
10/31/03	Correct dim / text errors	LRG
4/28/10	Notes/details to MUTCD	KJS

Sheet 1 of 1


State of Alaska
Department of Transportation
& Public Facilities
**PAVEMENT MARKING
APPLICATIONS**

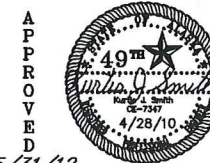



Date 5/31/12

GENERAL NOTES:


1. All symbols shown shall be white and reflectorized in accordance with the Special Provisions.
2. See "Standard Alphabets for Highway Signs and Pavement Marking" for letter layout.

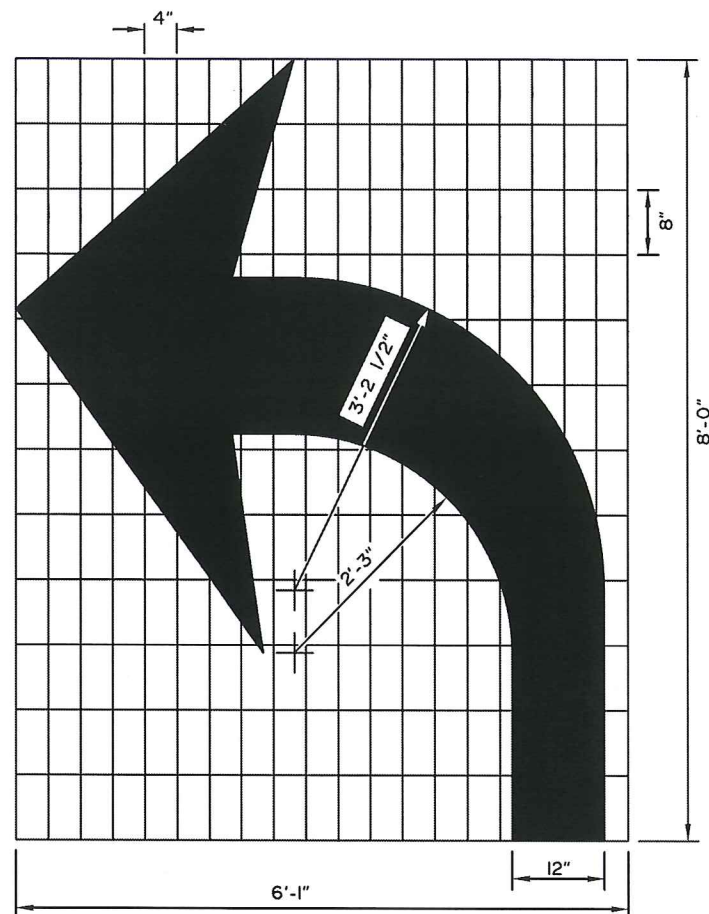


Right turn auxiliary lane usage markings identical except arrow symbol is reversed.

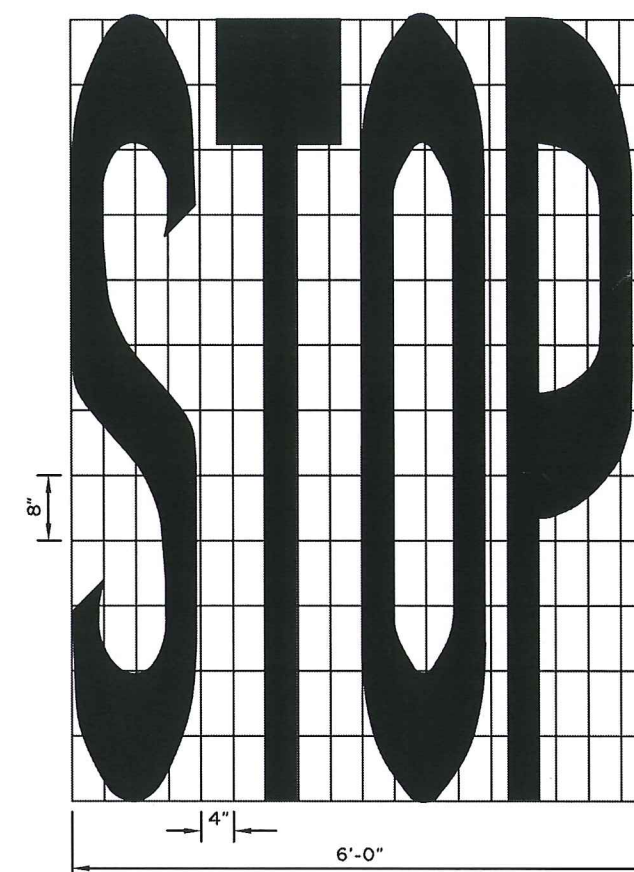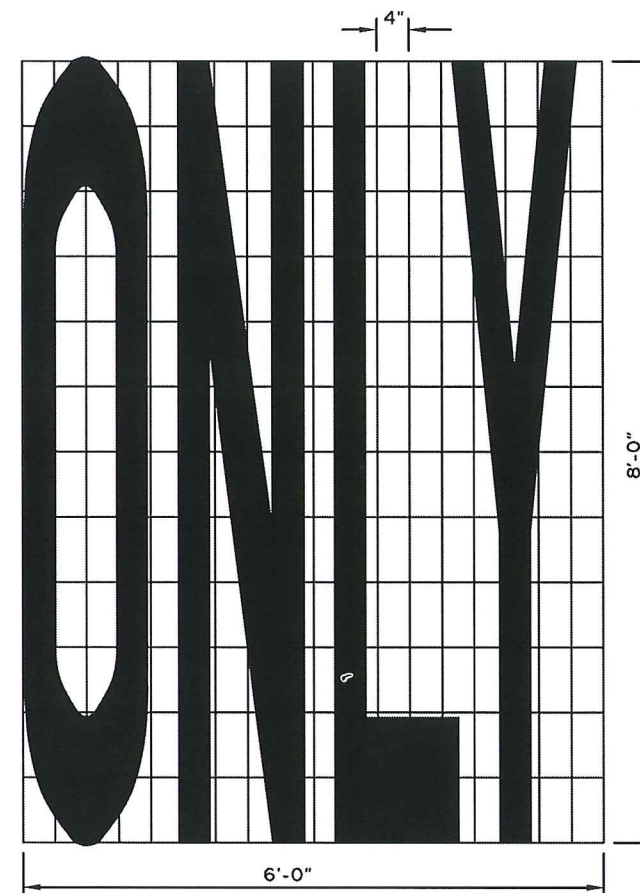


LAYOUT TEMPLATES FOR STENCILS

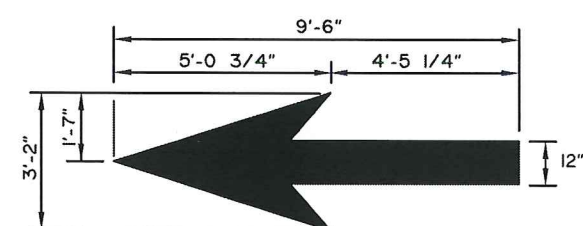


STRAIGHT AHEAD ARROW

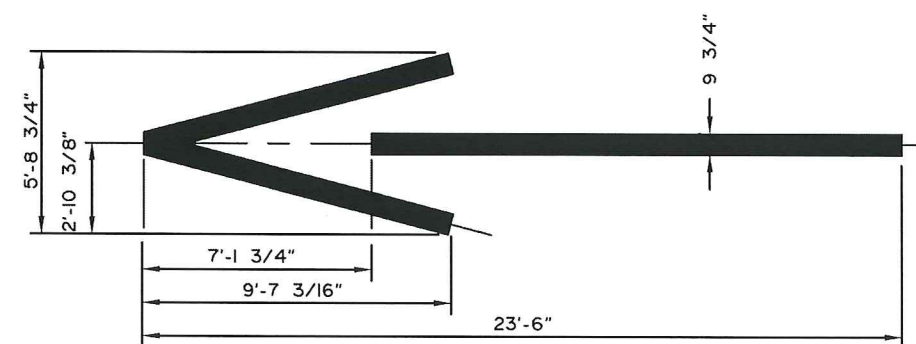

WRONG WAY ARROW

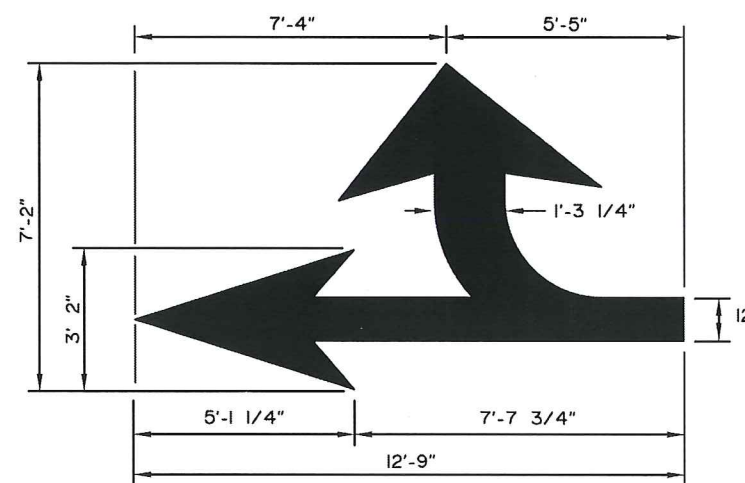

COMBINATION ARROW

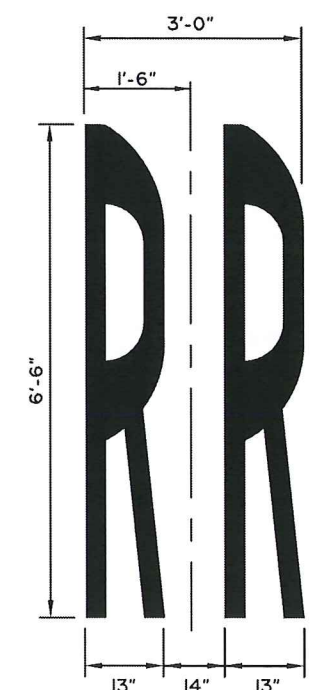

RAILROAD SYMBOL

REVISIONS		
Date	Description	By
1/1/86	Redraft Arrow Dim.	Gdo
4/1/93	Revise Arrow Markings	Gdo
2/15/00	Revise RR Symbol	KJS

State of Alaska
Department of Transportation
& Public Facilities

PAVEMENT MARKING SYMBOL DIMENSIONS



Date 1/1/86